


15-155-20224-0000

STATE OF KANSAS
STATE CORPORATION COMMISSION

Form CP-4

WELL PLUGGING RECORD

Give All Information Completely
Make Required Affidavit
Mail or Deliver Report to:
Conservation Division
State Corporation Commission
P. O. Box 17027
Wichita, Kansas 67217
NORTH

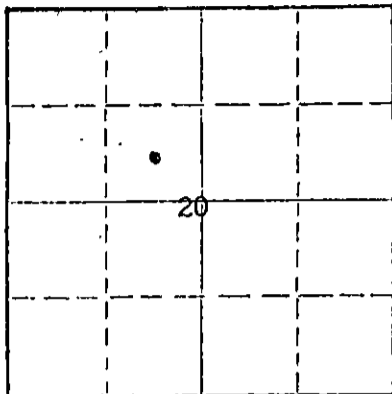

Locate well correctly on above
Section Plat

Reno County, Sec. 20 Twp. 22S Rge. 7 (E) (W)
Location as "NE/CNW/SW" or footage from lines C SE of NW 1/4 - 990
Lease Owner TransAmerica Oil Corporation
Lease Name Hungerford-Lolling Well No. #1
Office Address Box 518, Hutchinson, Kansas 67501
Character of Well (completed as Oil, Gas or Dry Hole) D & A
Date well completed August 15, 1973
Application for plugging filed (Phone call to Mr. Tobin) August 15, 1973
Application for plugging approved August 21, 1973
Plugging commenced 7 P.M. August 15, 1973
Plugging completed 8 P.M. August 15, 1973
Reason for abandonment of well or producing formation Dry

If a producing well is abandoned, date of last production none 19
Was permission obtained from the Conservation Division or its agents before plugging was commenced? yes

Name of Conservation Agent who supervised plugging of this well Mr. Tobin
Producing formation _____ Depth to top _____ Bottom _____ Total Depth of Well 3532 Feet
Show depth and thickness of all water, oil and gas formations.

OIL, GAS OR WATER RECORDS

CASING RECORD

FORMATION	CONTENT	FROM	TO	SIZE	PUT IN	PULLED OUT
Top 250'	surface cemented w/180 sx					

Describe in detail the manner in which the well was plugged, indicating where the mud fluid was placed and the method or methods used in introducing it into the hole. If cement or other plugs were used, state the character of same and depth placed, from 240' feet to 40' feet for each plug set.

Mud level to 240' ran plug with 1/2 sack hulls on top, 25 sx cement on top
filled hole to 40' set plug with 1/2 hulls on top ran 10 sax cement
plugged rat hole with 2 sax cement

RECEIVED
STATE CORPORATION COMMISSION
OCT 30 1973
CONSERVATION DIVISION
Wichita, Kansas
10-30-73

(If additional description is necessary, use BACK of this sheet)

Name of Plugging Contractor TransAmerica Oil Corporation
Address Box 518, Hutchinson, Kansas 67501

STATE OF Kansas, COUNTY OF Reno, ss.
Harold Brown (employee of owner) or (owner or operator) of the above-described well, being first duly sworn on oath, says: That I have knowledge of the facts, statements, and matters herein contained and the log of the above-described well as filed and that the same are true and correct. So help me God.

(Signature) Harold D. Brown
Box 518 Hutchinson Kansas (Address)

SUBSCRIBED AND SWORN to before me this 21st day of August, 1973

My commission expires January 12, 1977

Judy L. Niehoff
Notary Public.

JUDY L. NIEHOFF
STATE NOTARY PUBLIC
Reno County, Ks.
My Comm. Expires Jan. 12, 1977