


STATE OF KANSAS
STATE CORPORATION COMMISSION

Give All Information Completely
Make Required Affidavit
Mail or Deliver Report to:
Conservation Division
State Corporation Commission
800 Bittling Building
Wichita, Kansas

15-155-00404-0000
WELL PLUGGING RECORD

Reno County, Sec. 29 Twp. 22 Rge. (E) 7 (W)
Location as "NE/CNW $\frac{1}{4}$ /SW $\frac{1}{4}$ " or footage from lines SW SW SE
Lease Owner F. G. Holl
Lease Name Schardein Well No. 1
Office Address 6427 East Kellogg, Wichita, Kansas
Character of Well (completed as Oil, Gas or Dry Hole) Dry Hole
Date well completed 1-6-63 19
Application for plugging filed 2-15-63 19
Application for plugging approved 19
Plugging commenced 2-9-63 19
Plugging completed 2-9-63 19
Reason for abandonment of well or producing formation Non-commercial
If a producing well is abandoned, date of last production 19
Was permission obtained from the Conservation Division or its agents before plugging was commenced? Yes

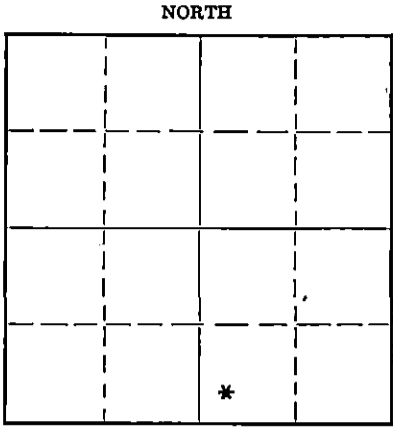

Locate well correctly on above Section Plot

Name of Conservation Agent who supervised plugging of this well Gib Toleman, Hollyrood
Producing formation Mississippi Depth to top 3532 Bottom 3554 Total Depth of Well 3554 Feet
Show depth and thickness of all water, oil and gas formations.

OIL, GAS OR WATER RECORDS

CASING RECORD

Formation	Content	From	To	Size	Put In	Pulled Out
				8 5/8"	275'	0'
				4 1/2"	3554'	3000'

Describe in detail the manner in which the well was plugged, indicating where the mud fluid was placed and the method or methods used in introducing it into the hole. If cement or other plugs were used, state the character of same and depth placed, from _____ feet to _____ feet for each plug set.

Sand @ 3520* 3 sacks cement on top
Hole filled with mud
Plug @ 270*
Rock bridge to 260*
Mud to 40*
Plug @ 40*
Rock bridge to 30*
10 sacks cement on top

RECEIVED
STATE CORPORATION COMMISSION
MAR 21 1963
3-21-63
CONSERVATION DIVISION
Wichita, Kansas

(If additional description is necessary, use BACK of this sheet)

Correspondence regarding this well should be addressed to _____
Address _____

STATE OF KANSAS, COUNTY OF SEDGWICK, ss.
True Knowles (employee of owner) or (owner or operator) of the above-described well,
being first duly sworn on oath, says: That I have knowledge of the facts, statements, and matters herein contained and the log of the above-described well as filed and that the same are true and correct. So help me God.

(Signature) _____
6427 East Kellogg, Wichita, Kansas
(Address)

SUBSCRIBED AND SWORN to before me this 12th day of March, 19 63

Notary Public.

My commission expires Jan. 31, 1967

15-155-00404-0000

WELL LOG

DATE COMMENCED: December 28, 1962

DATE COMPLETED: January 6, 1963

F. G. Holl
SCHARDEIN #1
SW SW SE 29-22-7W
Reno County, Kansas

ELEVATION: 1614 K.B.

0'	-	80'	Soil
25'	-	160'	Sand
160'	-	180'	Gravel
180'	-	257'	Red Shale
257'	-	475'	Red Shale
475'	-	700'	Shale
700'	-	1000'	Salt & Shale
1000'	-	1150'	Salt & Anhydrite
1150'	-	1250'	Shale
1250'	-	1500'	Lime
1500'	-	1850'	Shale & Shells
1850'	-	2200'	Shale
2200'	-	2300'	Lime
2300'	-	2500'	Shale
2500'	-	2819'	Lime & Shale
2819'	-	2824'	Black Shale (HEEBNER)
2824'	-	2846'	Lime & Shale
2846'	-	2994'	Shale & Sand (DOUGLAS)
2994'	-	3004'	Lime (BROWN LIME)
3004'	-	3018'	Shale
3018'	-	3352'	Lime & Shale (LANSING & K.C.)
3352'	-	3448'	Lime & Shale
3448'	-	3532'	Shale w/Lime Strks (CHEROKEE.)
3532'	-	3554'	Chert (MISSISSIPPI)

Heebner	2819	(-1205)
Douglas	2846	(-1232)
Brown Lime	2994	(-1380)
Lansing	3018	(-1404)
Base K.C.	3344	(-1730)
Marmaton	3352	(-1738)
Cherokee	3448	(-1834)
Mississippi	3534	(-1916)

CASING: 8 5/8 inch set at 275 feet with 200 sacks.

4 1/2 inch set at 3532 feet with 75 sacks common cement.

RECEIVED
STATE CORPORATION COMMISSION

MAR 21 1963
3-21-63
CONSERVATION DIVISION
Wichita, Kansas

AFFIDAVIT

State of Kansas County of Sedgwick

I, True Knowles, Geologist, do swear that the statements and matters herein contained are true to the best of my knowledge.

F. G. HOLL

By True Knowles
Geologist

Subscribed and sworn to before me this 11th day of February, 1963.

Mary C. Lacey
Notary Public

My Commission Expires: August 5, 1965