

STATE OF KANSAS
STATE CORPORATION COMMISSION
Give All Information Completely
Make Required Affidavit
Mail or Deliver Report to:
Conservation Division
State Corporation Commission
800 Bittling Building
Wichita, Kansas

OR
FORMATION PLUGGING RECORD

Strike out upper line
when reporting plug-
ging off formations.

Edwards County, Sec. 9 Twp. 24 Rge. (E) 16 (W)

Location as "NE $\frac{1}{4}$ NW $\frac{1}{4}$ SW $\frac{1}{4}$ " or footage from lines 330 North 330 West

Lease Owner Herndon Drilling Co

Lease Name Rudd Well No. 1

Office Address Box 1565 Tulsa Oklahoma

Character of Well (completed as Oil, Gas or Dry Hole) Dry Hole

Date well completed 7-5- 1942

Application for plugging filed 7-6- 1942

Application for plugging approved 7-6- 1942


Plugging commenced 7-7- 1942

Plugging completed 7-7- 1942

Reason for abandonment of well or producing formation Dry Hole

If a producing well is abandoned, date of last production 19

Was permission obtained from the Conservation Division or its agents before plugging was commenced? Yes

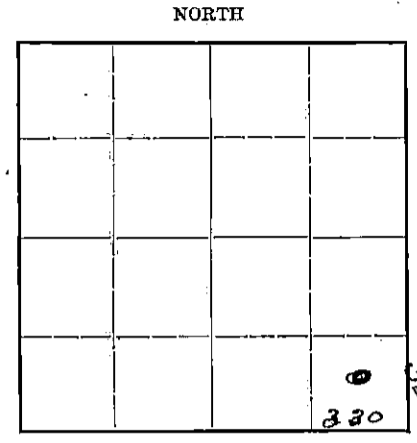

Locate well correctly on above Section Plat

Name of Conservation Agent who supervised plugging of this well Alexander

Producing formation _____ Depth to top _____ Bottom _____ Total Depth of Well 459 Feet

Show depth and thickness of all water, oil and gas formations.

Formation	Content	From	To	Size	Put In	Pulled Out
				<u>10 3/4</u>	<u>245</u>	<u>None</u>

Describe in detail the manner in which the well was plugged, indicating where the mud fluid was placed and the method or methods used in introducing it into the hole. If cement or other plugs were used, state the character of same and depth placed, from _____ feet to _____ feet for each plug set.

Budget hole at 245 feet in 13 sacks of cement filled with mud to 15 ft filled to bottom of cellar with cement. Budget at 10 ft. Hole was filled with 10.8 Polys mud

PLUGGING
FILE 9-24-166
BOOK PAGE 40 LINE 4

(If additional description is necessary, use BACK of this sheet)

Correspondence regarding this well should be addressed to _____ Address 7-15-42

STATE OF Kansas, COUNTY OF Reel, ss. _____ (employee of owner) or (owner or operator) of the above-described well,

being first duly sworn on oath, says: That I have knowledge of the facts, statements, and matters herein contained and the log of the above-described well as filed and that the same are true and correct. So help me God.

(Signature) W. J. Lyons
Lyons (Address) _____

SUBSCRIBED AND SWORN to before me this 14 day of July, 1942


My Commission Expires Nov. 7, 1945

WELL LOG BUREAU - KANSAS GEOLOGICAL SOCIETY
 412 Union National Bldg., Wichita, Kansas


15-047-00230-0000

HERNDON DRIG.CO.
 Rudd No. 1.

SEC. 9 T. 24 R. 16 W
 SEc SE

Total Depth. 4583'
 Comm. 6-3-42 Comp. 7-8-42
 Shot or Treated.
 Contractor.
 Issued. 7-25-42

County. Edwards

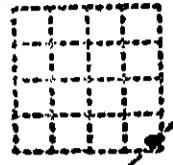

CASING:
 10 3/4" 245' Cem.

Elevation.

Production. Dry

Figures Indicate Bottom of Formations.

cellar	11
sand & shale	155
shale & shells	570
sand	630
shale & shells	1065
anhydrite	1100
shale & sand	1130
shale & shells	1580
salt & shells	1755
shale & shells	1770
lime	1790
shale & shells	1950
lime brkn	2190
lime	2275
shale & lime	2375
lime	2415
lime & shale	2570
lime brkn	2640
shale & lime	3350
shale & shells	3375
lime brkn	3425
lime	4070
lime & shale	4225
shale w/stks lime	4245 ^{MISS}
lime & chert	4325 ^{KAR}
shale, lime, chert	4340
shale & lime	4380 ^{V. 10}
lime & chert	4390
lime	4455
shale & lime	4510
sand	4514
lime	4583
Total Depth.	

Tops:	
Lansing-K.C.limestone	3815
Viola limestone	4513
Simpson formation	4518
Arbuckle dolomite	4548

9 24 16W
 40 41