


WELL PLUGGING RECORD

Give All Information Completely
Make Required Affidavit
Mail or Deliver Report to:
Conservation Division
State Corporation Commission
800 Bittling Building
Wichita, Kansas

Edwards County. Sec. 9 Twp. 24S Rge. 16 (W)

Location as "NE/CNW/SW" or footage from lines NE/4 NE/4 SW/4
Lease Owner White Eagle Oil Company
Lease Name COPPOC Well No. 1
Office Address 619 First Natl. Bldg., Tulsa 3, Oklahoma
Character of Well (completed as Oil, Gas or Dry Hole) DRY HOLE
Date well completed January 17 19 54
Application for plugging filed January 17 19 54
Application for plugging approved January 20 19 54
Plugging commenced January 25 19 54
Plugging completed January 30 19 54
Reason for abandonment of well or producing formation DRY HOLE

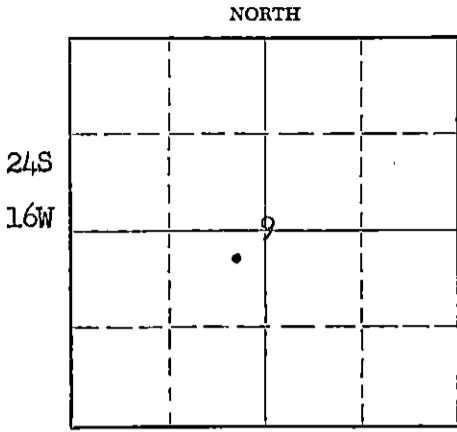

Locate well correctly on above Section Plat

If a producing well is abandoned, date of last production 19
Was permission obtained from the Conservation Division or its agents before plugging was commenced? yes

Name of Conservation Agent who supervised plugging of this well M. A. Rives
Producing formation _____ Depth to top _____ Bottom _____ Total Depth of Well 4435' Feet
Show depth and thickness of all water, oil and gas formations.

OIL, GAS OR WATER RECORDS KB-2075' GL 2071' CASING RECORD

FORMATION	CONTENT	FROM	TO	SIZE	PUT IN	PULLED OUT
Brown Lime		3744	-1669	8-5/8"	210'	None
Lansing		3754	-1679			
Base Kansas City		4020	-1945	5-1/2"	4202'	3510'
Miss. Lind		4190	-2115			
Kinderhook		4220	-2145			
Viola		4243	-2168			
Simpson		4399	-2324			
Arbuckle		4413	-2338			

Describe in detail the manner in which the well was plugged, indicating where the mud fluid was placed and the method or methods used in introducing it into the hole. If cement or other plugs were used, state the character of same and depth placed, from _____ feet to _____ feet for each plug set.

Set Lane Wells Plug at 4020' - circulated and pumped 120 bbls. mud.

Shot casing off at 3492' - pulled casing out of hole. Plugged well with mud -

bailed hole down to 10' - set permanent rock bridge at 209' - dumped

20 sacks cement to fill hole - capped well with 10 sacks cement.

work started Jan. 25, 1954; completed Jan. 30, 1954

Name of Plugging Contractor J. O. Forbes dba/Forbes Casing Pulling Company
Address P. O. Box 221, Great Bend, Kansas

STATE OF Oklahoma, COUNTY OF Tulsa, ss.
Ernest C. Pohl, Asst. Mgr. Prod. (employee of owner) or (owner or operator) of the above-described well, being first duly sworn on oath, says: That I have knowledge of the facts, statements, and matters herein contained and the log of the above-described well as filed and that the same are true and correct. So help me God.

(Signature) Ernest C. Pohl, Assistant Manager of Production
White Eagle Oil Co., First Natl. Bldg., Tulsa, Okla
(Address)

SUBSCRIBED AND SWORN TO before me this 10th day of February, 19 54

My commission expires 8-19-57

Ragmar Waldrop
Notary Public.

PLUGGING
FILE SEC 9 T 24 R 16W
BOOK PAGE 9 LINE 10

2-11-54

Company: Helmerich and Payne Inc.

NE-NE-SW
Sec. 9, Twn. 24 Rge16
County: Edwards,
Kansas

Farm: Coppoc Well No. 1
Total Depth: 4435'

Comm: 12-10-53 Comp: 1-5-54
Contractor: Peel Bros. Inc.

Elevation:

Casing:
8 5/8" @ 209' Cem.
8 1/2" @ 4202' Cem.

Production:

Figures below indicate bottom of formation

Surface Clay and Sand	0'	145'
Sand streak and Shale		185
Blue Shale		210
Shale		320
Sand		390
Red-bed and Shale		528
Sand (well-flow)		610
Red-bed		760
Sand and Red-bed		940
Shale		1030
Anhydrite		1065
Shale and Shells		1570
Shale		1895
Lime and Shale		2005
Lime		2105
Lime and Shale		2660
Lime and Shale streaks		2725
Shale and Lime		2870
Shale and Lime streaks		3120
Lime and Shale		3182
Shale and Lime streaks		3235
Lime and Shale		3310
Lime and Shale streaks		3460
Lime and Shale		3600
Lime		3695
Lime and Shale		3814
Lime		3920
Lime and Cherty		3945
Lime		4000
Cherty Lime		4045
Lime		4235
Lime, Shale and Chert		4270
Viola Lime		4300
Lime Cherty		4330
Lime, Chert and Shale		4350
Viola Lime		4375
Lime		4411
Dolomite		4435
Total Depth		4435

This is to certify that the above information is to the best of my knowledge true and correct.

PEEL BROS. INC.

BY Mendell E. Peel

SUBSCRIBED AND SWORN TO before me this 9 day of January 1954

My Commission expires September 28th, 1957.

Norma L. Reese
Notary Public

PLUGGING
FILE SEC 9 T24 R16W
BOOK PAGE 9 LINE 10

REGISTRATION DIVISION
Wichita, Kansas

2-11-54