


STATE OF KANSAS
STATE CORPORATION COMMISSION

WELL PLUGGING RECORD

Give All Information Completely
Make Required Affidavit
Mail or Deliver Report to:
Conservation Division
State Corporation Commission
211 No. Broadway
Wichita, Kansas

Edwards County, Sec. 9 Twp. 24 Rge. 16 (X) (W)

Location as "NE/CNW&SW" or footage from lines NW SW NE
Lease Owner M. B. Armer
Lease Name Enlow Well No. 1
Office Address 710 Petroleum Bldg., Wichita, Kansas
Character of Well (completed as Oil, Gas or Dry Hole) well depleted
Date well completed Nov. 28 19 53
Application for plugging filed Dec. 31 19 56
Application for plugging approved Dec. 31 19 56
Plugging commenced Dec. 31 19 56
Plugging completed Jan. 4 19 57
Reason for abandonment of well or producing formation oil well depleted

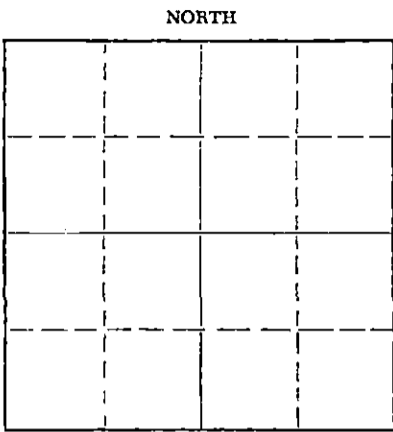

Locate well correctly on above Section Plat

If a producing well is abandoned, date of last production November 25 19 56
Was permission obtained from the Conservation Division or its agents before plugging was commenced? Yes

Name of Conservation Agent who supervised plugging of this well M. A. Rives
Producing formation _____ Depth to top _____ Bottom _____ Total Depth of Well 3,780 Feet
Show depth and thickness of all water, oil and gas formations.

OIL, GAS OR WATER RECORDS

CASING RECORD

FORMATION	CONTENT	FROM	TO	SIZE	PUT IN	PULLED OUT
				8 5/8	229	None
				5 1/2	3780	3199

Describe in detail the manner in which the well was plugged, indicating where the mud fluid was placed and the method or methods used in introducing it into the hole. If cement or other plugs were used, state the character of same and depth placed, from _____ feet to _____ feet for each plug set.

3759 ft. to 3715 ft. Sand bridge
 3715 ft. to 3685 ft. 5 sacks cement
 Surface hole circulated with 60 sacks mud by
 Globe Cementing Co. at 1200 ft.
 225 ft. to 210 ft. Rock bridge
 210 ft. to 150 ft. 20 sacks cement
 150 ft. to 35 ft. Mud
 35 ft. to cellar 10 sacks cement

(If additional description is necessary, use BACK of this sheet)

Name of Plugging Contractor R & S Pipe Pulling Co.
Address Ellenwood, Kansas

STATE OF Kansas COUNTY OF Sedgwick, ss.
L. C. Sponenberg (employee of owner) of the above-described well, being first duly sworn on oath, says: That I have knowledge of the facts, statements, and matters herein contained and the log of the above-described well as filed and that the same are true and correct. So help me God.

(Signature) L. C. Sponenberg

SUBSCRIBED AND SWORN TO before me this 17th day of January, 19 57

My commission expires February 13, 1960

J. P. Furey Notary Public.
STATE CORPORATION COMMISSION

PLUGGING
FILE SEC 9 T 24 R 16W
BOOK PAGE 129 LINE 33

JAN 18 1957 1-18-57
CONSERVATION DIVISION
Wichita, Kansas

LOG

Company: M. B. Armer
 Contractor: Armer, Inc.
 Drilling Commenced: 11/7/53
 Drilling Completed: 11/23/53
 Elevation: 2072 Gr.
 2074 D.F.

Farm: Enlow #1
 Location: NW SW NE Sec. 9-24S-16W
 Edwards County, Kansas
 Casing Record - 8 5/8" casing at 229'
 with 125 sacks cement
 5 1/2" casing at 3780'

(Figures below indicate bottoms.)

Surface Clay & Sand	98
Shale	229
Red Bed & Shale	540
Sand	580
Red Bed & Shells	990
Anhydrite	1020
Shale & Sand	1180
Shale, Lime, Red Bed & Pyrite	1195
Shale, Shells & Salt	1650
Shale & Shells	2020
Shale & Lime Shells	2120
Lime - Broken	2180
Lime	2270
Shale & Lime	2635
Shale & Lime Shells	2730
Shale & Shells	3207
Shale & Lime	3285
Lime	3360
Lime & Shale	3435
Shale & Lime Shells	3515
Lime	3665
Shale & Lime	3720
Lime	3780

FORMATION TOPS (R.B. Meas.)

HEEBNER	3576
LANSING	3701
TOTAL DEPTH	3780

I hereby certify that this is a true and correct log of the above described well as shown by the drilling reports.

ARMER, INC.

By *C. P. Spruill*

STATE OF KANSAS

SS:

COUNTY OF SEDGWICK

Subscribed and sworn to before me, a notary public, in and for said County and State this 24th day of November, 1953.

Lorraine M. Johnson
 Notary Public

My Commission expires October 13, 1956.

PLUGGING	
FILE	SEC 9 T. 24 R. 16W
BOOK	PAGE 129 LINE 33

RECEIVED
 DEPT. OF COMMISSION

1-2-57
 DIVISION
 Kansas