

STATE OF KANSAS  
STATE CORPORATION COMMISSION  
CONSERVATION DIVISION  
200 Colorado Derby Building  
Wichita, Kansas 67202

Rev. 2/89

RECEIVED  
STATE CORPORATION COMMISSION

10-19-89  
CONSERVATION DIVISION  
Wichita, Kansas

**WELL PLUGGING APPLICATION FORM**  
(File One Copy)

**API NUMBER** 15-047-20,796-0000 (of this well).  
(This must be listed; if no API# was issued, please note drilling completion date.)

**WELL OWNER/OPERATOR** B T A Operating **OPERATOR'S LICENSE NO.** 30149

**ADDRESS** Box 3846 Edmond, OK. 73083 **PHONE #** (405) 377-9273

**LEASE (FARM)** Bernard A. Meye **WELL NO.** 5 **WELL LOCATION** 890' FSL 2310 **COUNTY** Edwards

**SEC.** 23 **TWP.** 24 **RGE.** 16W **(E) or (W)** **TOTAL DEPTH** 4169 **PLUG BACK TD** 4116

**Check One:**

**OIL WELL**  **GAS WELL**  **D & A**  **SWD or INJ WELL**  **DOCKET NO.** \_\_\_\_\_

**SURFACE CASING SIZE** 8 5/8 **SET AT** 460 **CEMENTED WITH** 300 **SACKS**

**CASING SIZE** 5 1/2 **SET AT** 4165 **CEMENTED WITH** 340 **SACKS**

**PERFORATED AT** 3796'-3808'

**CONDITION OF WELL:** **GOOD**  **POOR**  **CASING LEAK**  **JUNK IN HOLE**

**PROPOSED METHOD OF PLUGGING** WE WILL PLUG WELL ACCORDING TO THE RULES AND REGULATIONS OF THE STATE OF KANSAS.

(If additional space is needed use back of form.)

**IS WELL LOG ATTACHED TO THIS APPLICATION AS REQUIRED?** Yes **IS ACC-1 FILED?** \_\_\_\_\_  
(If not explain.)

**DATE AND HOUR PLUGGING IS DESIRED TO BEGIN** ASAP

**PLUGGING OF THIS WELL WILL BE DONE IN ACCORDANCE WITH K.S.A. 55-101 et. seq. AND THE RULES AND REGULATIONS OF THE STATE CORPORATION COMMISSION.**

**NAME OF REPRESENTATIVE AUTHORIZED TO BE IN CHARGE OF PLUGGING OPERATIONS:**

B T A Operating **PHONE #** (405) 377-9273

**ADDRESS** Same As Above

**PLUGGING CONTRACTOR** Kelso Casing Pulling, Inc. **LICENSE NO.** 6050

**ADDRESS** P.O. Box 347 Chase, KS. 67524 **PHONE #** (316) 938-2943

**PAYMENT OF THE PLUGGING FEE (K.A.R. 82-9-118) WILL BE GUARANTEED BY OPERATOR OR AGENT.**


**SIGNED:** [Signature]  
(Operator or Agent)

**DATE:** 10/17/89

①

KB. = 2071'  
 D.F. - 2068'  
 G.L. - 2060'

B. Meyer # 5  
 Edwards Co., Kansas  
 Section 23 - T245 - R16W

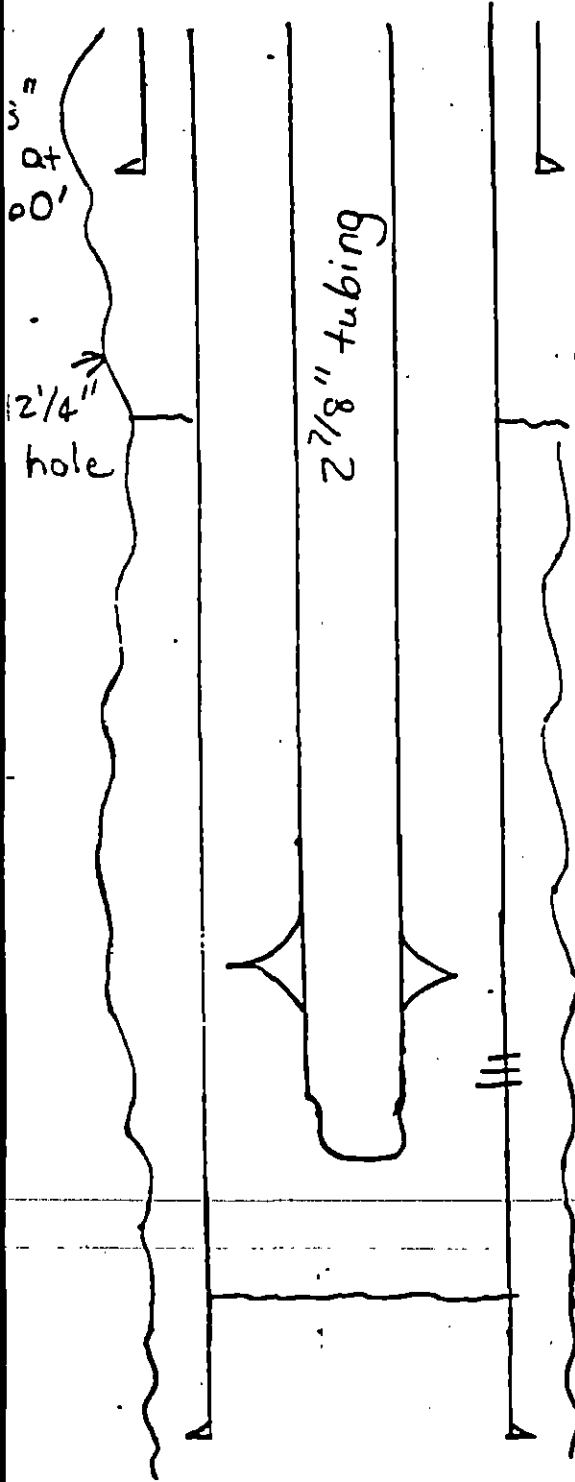

Casing & tubing Program

Size	Wt	Gr	Set D	Burst #	Collapse
8 5/8"	24#	K-55	860'	2500	1200
5 1/2"	14#	K-55	4165'	3900	2140
2 7/8"	6.5#	J-55	3820'	6880	6830

Before w/o

tubing Anchor at 3757'  
 ≡ 3796'-3808'. Lansing - Kansas City 'A'  
 Seating Nipple at 3920' (I.D. = 2.313")  
 Mud Anchor at 3850'  
 P.B.T.D at 4125'  
 } 5 1/2" csg set at 4165'  
 T.D. at 4169'

M.K.V  
 4/15/81

RECEIVED  
 STATE CORPORATION COMMISSION  
 OCT 19 1980  
 CONSERVATION DIVISION  
 Wichita, Kansas

\* Includes S.F. = 1.125



Kansas Corporation Commission

MIKE HAYDEN GOVERNOR  
KEITH R. HENLEY CHAIRMAN  
RICH KOWALEWSKI COMMISSIONER  
MARGALEE WRIGHT COMMISSIONER  
JUDITH MCCONNELL EXECUTIVE DIRECTOR  
FRANK A. CARO, JR. GENERAL COUNSEL

CONSERVATION DIVISION  
SHARI FEIST ALBRECHT, DIRECTOR  
200 Colorado Derby Bldg.  
202 W. 1st Street  
Wichita, KS 67202-1286  
(316) 263-3238

90 DAYS NOTICE

JAN 1 1990

EXPIRES

October 19, 1989

NOTICE OF RECEIPT OF  
WELL PLUGGING APPLICATION

B T A Operating  
Box 3846  
Edmond, OK 73083

Bernard A. Meyer 5  
890'FSL-2310'FEL  
23-24-16W  
Edwards County

Gentlemen:

This letter is to notify you that the Conservation Division is in receipt of your plugging proposal, form CP-1, for the above-captioned well.

Your CP-1 has been reviewed by the Conservation Division central office for completeness and to verify license numbers. The plugging proposal will now be forwarded to the district office listed below for review of your proposed method of plugging. Please contact the district office to review your proposed plugging method at least five (5) days before plugging the well.

It has recently come to my attention that the form CP-1 has been filed by operators other than the owner or operator of the well and without the consent of the owner or operator. The Conservation Division's review of form CP-1, either in the central or district office, does not include an inquiry into well ownership or the filing operator's legal right to plug the well. The CP-1 is simply reviewed to determine compliance with plugging rules and regulations.

This notice in no way constitutes authorization to plug the above-captioned well by persons not having legal rights of ownership or interest in the well. This notice is void after ninety (90) days from the above date.

Sincerely,

*Shari Feist Albrecht*

Shari Feist Albrecht  
Director

District: # 1 304 W. McArtor  
Dodge City, KS. 67801  
(316) 225-6760