


STATE OF KANSAS
STATE CORPORATION COMMISSION

Give All Information Completely
Make Required Affidavit
Mail or Deliver Report to:
Conservation Division
State Corporation Commission
800 Bittling Building
Wichita, Kansas

WELL PLUGGING RECORD

NORTH

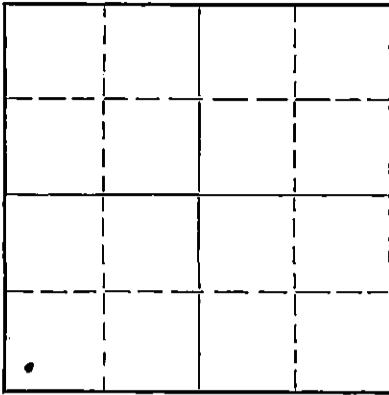

Locate well correctly on above
Section Plat

Pratt County. Sec. 18 Twp. 29 Rge. 14 (E) W (W)
Location as "NE/CNW $\frac{1}{4}$ SW $\frac{1}{4}$ " or footage from lines SW SW SW
Lease Owner Lion Oil Company
Lease Name Nellie Well No. 1
Office Address Box 552, Pratt, Kansas
Character of Well (completed as Oil, Gas or Dry Hole) Dry Hole
Date well completed 10-11 1950
Application for plugging filed 10-11 1950
Application for plugging approved 10-11 1950
Plugging commenced 10-11 1950
Plugging completed 10-11 1950
Reason for abandonment of well or producing formation Dry Hole

If a producing well is abandoned, date of last production 19
Was permission obtained from the Conservation Division or its agents before plugging was commenced? Yes

Name of Conservation Agent who supervised plugging of this well C. D. Stough
Producing formation Depth to top Bottom Total Depth of Well 4654 Feet
Show depth and thickness of all water, oil and gas formations.

OIL, GAS OR WATER RECORDS

CASING RECORD

Formation	Content	From	To	Size	Put In	Pulled Out

Describe in detail the manner in which the well was plugged, indicating where the mud fluid was placed and the method or methods used in introducing it into the hole. If cement or other plugs were used, state the character of same and depth placed, from feet to feet for each plug set.

Heavy mud to 250' set bridging plug with 15 sacks of cement
Heavy mud to 35' set bridging plug with 10 sacks of cement

RECEIVED
STATE CORPORATION COMMISSION
OCT 20 1950
CONSERVATION DIVISION
Wichita, Kansas
10-20-50

(If additional description is necessary, use BACK of this sheet)
Correspondence regarding this well should be addressed to Vernon Hayes
Address Box 552
Pratt, Kansas

STATE OF Kansas, COUNTY OF Pratt, ss.
Vernon Hayes (employee of owner) or (owner or operator) of the above-described well,
being first duly sworn on oath, says: That I have knowledge of the facts, statements, and matters herein contained and the log of the above-described well as filed and that the same are true and correct. So help me God.

(Signature) *Vernon Hayes*
Box 552, Pratt, Kansas (Address)

SUBSCRIBED AND SWORN TO before me this 19th day of October, 1950

My commission expires with office

Patricia Hannigan Reg. of Deeds
Pauline Lawrence Notary Public

23-3273-8 4-50-10M

PLUGGING
FILE SEC 13 T 29 R 14
BOOK PAGE 35 LINE 9

Nellie Well No. 1

SW SW SW,
Sec. 13-29S-14W
Pratt County
Kansas

Contractor: The R. W. Rine Drilling Company
Started: 9/26/50 Finished 10/11/50

Log

Clay-Sand-Gravel	0	=	40	
Sand = Gravel	40	=	165	
Red Bed = Shells	165	=	418	8-5/8" @ 418' w/200 Sx.
Red Bed= Shale	418	=	900	Syfo @ 500' = 1/2°
Shale = Shells	900	=	1945	Syfo @ 1000' = 1/2°
Lime	1945	=	2175	Syfo @ 1500' = 0.K.
Shale	2175	=	2265	Syfo @ 2000' = 0.K.
Lime	2265	=	2635	Syfo @ 2500' = 1°
Shale	2635	=	2665	
Lime	2665	=	2725	
Lime = Shale	2725	=	3050	Syfo @ 3000' = 1°
Shale	3050	=	3090	
Lime	3090	=	3130	
Shale = Lime	3130	=	3375	
Lime	3375	=	3575	Syfo @ 3500' =
Lime = Shale	3575	=	3675	Losing mud 3420-3475
Lime	3675	=	3736	
Lime = Shale	3736	=	3830	
Shale	3830	=	3870	
Lime	3870	=	3925	
Lime = Shale	3925	=	3995	
Lime	3995	=	4315	Syfo @ 4000' = 6°
Lime = Shale	4315	=	4370	
Lime	4370	=	4408	
Lime = Chert	4408	=	4443	
Lime	4443	=	4536	
Lime = Sand	4536	=	4569	
Lime	4569	=	4603	
Lime = Chert	4603	=	4640	
Lime	4640	=	4654	TD D&A
				Plugged: @ 250' w/ 15 Sx.
				@ 35' w/ 10 Sx.
Tops: Lansing	3935			
Viola	4419			
Simpson Shale	4513			
Arbuckle	4609			
T. D.	4652			

RECEIVED
STATE CORPORATION COMMISSION
OCT 20 1950
CONSERVATION DIVISION
Wichita, Kansas

State of Kansas)
County of Sedgwick) ss.

I, E. H. Sloyer, do hereby certify that the above is a true and accurate log of the Nellie Well No. 1, located in the SW SW SW of Sec. 13-29S-14W, Pratt County, Kansas.

E. H. Sloyer
Secretary

Subscribed to and sworn before me this 16th day of October, 1950

My commission expires Dec. 29, 1952

R. M. Green
Notary Public

PLUGGING
FILE SEC 13 T 29 S 14 W
BOOK PAGE 35 LINE 9