

STATE OF KANSAS
STATE CORPORATION COMMISSION


WELL PLUGGING RECORD

Give All Information Completely
Make Required Affidavit
Mail or Deliver Report to
Conservation Division
State Corporation Comm.
245 North Water
Wichita, KS 67202

Edwards County. Sec. 4 Twp. 24S Rge. 16 E/W
Location as "NE/CNW $\frac{1}{4}$ SW $\frac{1}{4}$ " or footage from lines
SW SW NE

Lease Owner Imperial Oil Co.
Lease Name Neeland Gas Unit Well No. #2
Office Address 720 4th Financial Center Wichita, Ks.
Character of Well (Completed as Oil, Gas or Dry Hole)
Dry Hole

Date Well completed 4-17 1981
Application for plugging filed 4-17 1981
Application for plugging approved 4-17 1981
Plugging commenced 4-17 1981
Plugging completed 4-17 1981
Reason for abandonment of well or producing formation _____

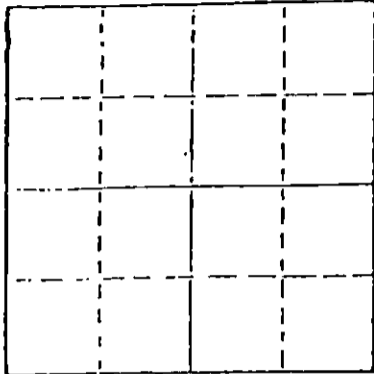

Locate well correctly on above
Section Plot

If a producing well is abandoned, date of last production
_____ 19____

Was permission obtained from the Conservation Division or
its agents before plugging was commenced? Yes

Name of Conservation Agent who supervised plugging of this well Wm. T. Owen
Producing formation _____ Depth to top _____ Bottom _____ Total Depth of Well 4260'
Show depth and thickness of all water, oil and gas formations.

OIL, GAS OR WATER RECORDS

CASING RECORD

FORMATION	CONTENT	FROM	TO	SIZE	PUT IN	PULLED OUT
				8 5/8"	316'	265 sx.

Describe in detail the manner in which the well was plugged, indicating where the mud fluid
was placed and the method or methods used in introducing it into the hold. If cement or other
plugs were used, state the character of same and depth placed, from _____ feet to
_____ feet for each plug set.

- 600', plug, 50 sx. cement.
- 300', plug, 30 sx. cement.
- 40', plug, 10 sx. cement.
- 12 sx. in rathole.
- 3 sx. in water well.

RECEIVED
STATE CORPORATION COMMISSION
5-5-81
MAY 5 1981
CONSERVATION DIVISION
Wichita, Kansas

(If additional description is necessary, use BACK of this sheet)

Name of Plugging Contractor White & Ellis Drilling, Inc.
401 E. Douglas Suite 500 Wichita, Ks. 67202

STATE OF Kansas COUNTY OF Sedgwick, ss.
Ernest Sifford (employee of owner) or (owner or operator)
of the above-described well, being first duly sworn on oath, says: That I have knowledge of
the facts, statements, and matters herein contained and the log of the above-described well
as filed and that the same are true and correct. So help me God.

(Signature) [Signature]
401 E. Douglas #500 Wichita, Ks. 67202
(Address)

SUBSCRIBED AND SWORN TO before me this 1st day of May, 1981

GLORIA JAMES
NOTARY PUBLIC
STATE OF KANSAS
My Comm. Exp. 4/6/85
April 6, 1985

My commission expires _____

Gloria James
Gloria James Notary Public.

DRILLERS LOG

OPERATOR: Imperial Oil Co. 720 4th Financial Center Wichita, Ks. 67202
 CONTRACTOR: White & Ellis Drilling, Inc., Box 448, El Dorado, Kansas 67042

Lease Name Neeland Gas Unit Well No. #2
 Sec. 4 T. 24S R. 16W Spot SW SW NE
 County Edwards State Kansas Elevation _____

Casing Record:

Surface: 8 5/8" @ 316' with 265 Sxs.

Production: _____ @ _____ with _____ Sxs.

Type Well: D&A Total Depth 4260'

Drilling Commenced: 4-10-81 Drilling Completed 4-17-81

Formation	From	To	Tops
Cellar	0	7	
Shale, Lime	7	1530	
Sand	1530	1994	
Sand, Shale	1994	2595	
Shale, Lime	2595	4260	

RECEIVED
 STATE CORPORATION COMMISSION
 MAY - 5 1981
 CONSERVATION DIVISION
 Wichita, Kansas

COMPLETION RECORD

Liner Record: Size _____ From _____ To _____

Cementing Record: _____ Sacks _____

Perforating Record:

Formation	Perforated Interval	Number Shots
_____	_____	_____
_____	_____	_____
_____	_____	_____
_____	_____	_____

Initial Production: _____

Electric Log _____ Type and Depths Covered _____

