


STATE OF KANSAS
STATE CORPORATION COMMISSION

WELL PLUGGING RECORD

Give All Information Completely
Make Required Affidavit
Mail or Deliver Report to
Conservation Division
State Corporation Comm.
245 North Water
Wichita, KS 67202

Edwards County, Sec. 3 Twp. 24 Rge. 16 E/W
Location as "NE/CNW $\frac{1}{4}$ SW $\frac{1}{4}$ " or footage from lines
C of NE NE
Lease Owner Sterling Drilling Company
Lease Name Cummins #1 Well No. _____
Office Address Sterling, Kansas 67579
Character of Well (Completed as Oil, Gas or Dry Hole) _____

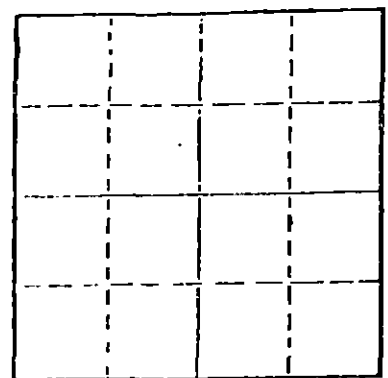

Locate well correctly on above
Section Plot

Date Well completed _____ 19____
Application for plugging filed _____ 19____
Application for plugging approved _____ 19____
Plugging commenced 10/23/78 _____ 19____
Plugging completed 10/25/78 _____ 19____
Reason for abandonment of well or producing formation
depleted.
If a producing well is abandoned, date of last production _____ 19____

Was permission obtained from the Conservation Division or
its agents before plugging was commenced? yes _____

Name of Conservation Agent who supervised plugging of this well Owens
Producing formation _____ Depth to top _____ Bottom _____ Total Depth of Well 4190
Show depth and thickness of all water, oil and gas formations.

OIL, GAS OR WATER RECORDS

CASING RECORD

FORMATION	CONTENT	FROM	TO	SIZE	PUT IN	PULLED OUT
				8-5/8	256	none
				4 1/2"	2278	1886'

Describe in detail the manner in which the well was plugged, indicating where the mud fluid
was placed and the method or methods used in introducing it into the hold. If cement or other
plugs were used, state the character of same and depth placed, from _____ feet to
_____ feet for each plug set.

Pushed plug to 2050', sanded to 2000' and ran 4 sacks cement. Shot pipe at 1875',
pulled 45 joints. Squeezed hole with 3 sacks hulls, 20 sacks gel, released plug and
displaced with 100 sacks 60/40 pozmix, 2% gel., 3% cc.

PLUGGING COMPLETE.

RECEIVED
STATE CORPORATION COMMISSION
11-6-78
NOV 6 1978
11-6-78
CONSERVATION DIVISION
Wichita, Kansas

(If additional description is necessary, use BACK of this sheet)
Name of Plugging Contractor KESLO CASING PULLING
CHASE, KANSAS


STATE OF KANSAS COUNTY OF RICE, ss.
R. DARRELL KELSO (employee of owner) or (owner or operator)
of the above-described well, being first duly sworn on oath, says: That I have knowledge of
the facts, statements, and matters herein contained and the log of the above-described well
as filed and that the same are true and correct. So help me God.

(Signature) R. Darrell Kelso
CHASE, KANSAS
(Address)

SUBSCRIBED AND SWORN TO before me this 31st day of October, 19 78

Margaret Melcher
Notary Public.

My commission expires _____

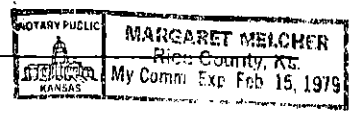

STERLING DRILLING COMPANY
P. O. Box 129
Sterling, Kansas 67579

WELL LOG - - - - - CUMMINS #1
Located: C NE NE, Section 3-24S-16W, Edwards County, Kansas

OWNER: Sterling Drilling Company, et al
ROTARY DRILLING CONTRACTOR: Sterling Drilling Company

COMMENCED: December 20, 1977
COMPLETED: January 2, 1978

TOTAL DEPTH: 4190'

<u>LOG</u>	<u>CASING RECORD</u>
0 - 259 Sand - Shale	Ran 6 joints 8 5/8" casing, 244.25' set at 256' K.B. with 225 sacks 60/40 Pozmix #1, 3% cc. Plug down at 3:30 PM, 12-20-77, by Howco.
259 - 995 Shale - Shells	
995 - 2605 Shale and Lime	
2605 - 2775 Lime	
2775 - 3750 Lime and Shale	
3750 - 4190 Lime	Ran 55 joints 4 1/2", 10.5#, 8rd, Range 3 casing, 2269.49' set at 2278' with 125 sacks 50/50 Pozmix, 2% gel, 18% salt; .75% CFR-2. Plug down at 7:30 PM, 1-2-78.

RECEIVED
STATE CORPORATION COMMISSION

OCT 10 1978

CONSERVATION DIVISION
Wichita, Kansas