


WELL PLUGGING RECORD

All information Completely
Required Affidavit
Per Deliver Report to:
Conservation Division
State Corporation Commission
211 No. Broadway
Wichita, Kansas

Edwards County. Sec. 2 Twp. 24S Rge. 16 ~~(XX)~~ (W)
Location as "NE/CNW/SW" or footage from lines SW NE SE
Lease Owner Wilco Oil, Inc.
Lease Name Klein Well No. 1
Office Address Box 13528, Phoenix, Arizona
Character of Well (completed as Oil, Gas or Dry Hole) Oil
Date well completed August 13 1949
Application for plugging filed September 4 1963
Application for plugging approved 19
Plugging commenced September 20 1963
Plugging completed September 28 1963
Reason for abandonment of well or producing formation Uneconomic producer

NORTH

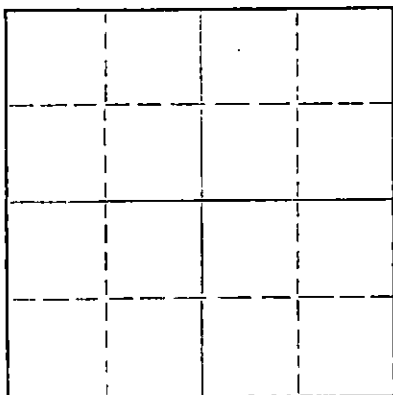

Locate well correctly on above
Section Plat

If a producing well is abandoned, date of last production September 1963
Was permission obtained from the Conservation Division or its agents before plugging was commenced? Yes

Name of Conservation Agent who supervised plugging of this well Archie V. Elving
Producing formation Lansing-Kansas City Depth to top 3582 Bottom 3871 Total Depth of Well 3943 Feet
Show depth and thickness of all water, oil and gas formations.

OIL, GAS OR WATER RECORDS

CASING RECORD

FORMATION	CONTENT	FROM	TO	SIZE	PUT IN	PULLED OUT
<u>Lansing-Kansas City</u>	<u>Gas, oil, wtr.</u>	<u>3582</u>	<u>3871</u>	<u>8 5/8</u> <u>5 1/2</u>	<u>280</u> <u>3806</u>	<u>2595</u>

Describe in detail the manner in which the well was plugged, indicating where the mud fluid was placed and the method or methods used in introducing it into the hole. If cement or other plugs were used, state the character of same and depth placed, from _____ feet to _____ feet for each plug set.

Cement plug @ 3600' 5 sks
Mud from 3560 to 290' 15' Rock Bridge
45 sks cement to base of cellar

RECEIVED
STATE CORPORATION COMMISSION

DEC 10 1963
12-10-63

CONSERVATION DIVISION
Wichita, Kansas

(If additional description is necessary, use BACK of this sheet)

Name of Plugging Contractor Glenn & Smith
Address Box 156, Ellinwood, Kansas

STATE OF KANSAS COUNTY OF SEDGWICK, ss.

(employee of owner) or (owner or operator) of the above-described well, being first duly sworn on oath, says: That I have knowledge of the facts, statements, and matters herein contained and the log of the above-described well as filed and that the same are true and correct. So help me God.

(Signature) James R Daniels
James R. Daniels
308 Schweiter Building, Wichita, Kansas
(Address)

SUBSCRIBED AND SWORN to before me this 6th day of December, 1963

My commission expires November 18, 1966

Colleen Chapple
Colleen Chapple Notary Public.

Drilling Log

Operator: Max Cohen (now Wilco Oil, Inc.)
Contractor: Brunson Drilling Company
Commenced: 7/29/49
Completed: 8/13/49
Elevation: 2051 R. B.

Well: Klein No. 1
Location: SW NE SE Sec. 2-24S-16W
Edwards County, Kansas
Casing: 8 5/8" at 280'
5 1/2" at 3806'

Figures below indicate bottoms of formations:

Formation Tops

Sand	125'	Anhydrite	948'
Clay & Sand	200'	Topeka	3146'
Shale & Shells	300'	Heebner	3447'
Red Shale	450'	Toronto	3466'
Sand	500'	Lans. K.C.	3582'
Shale & Shells	625'	Base K.C.	3871'
Red Shale & Shells	950'	Pre Cambrian	3942'
Anhydrite	995'	Total Depth	3943'
Shale & Shells	1300'		
Sandy red shale & shells	1620'		
Shale	1800'		
Shale & Lime	2640'		
Shale	2880'		
Lime & Shale	3145'		
Lime	3447'		
Shale (Heebner)	3452'		
Lime	3480'		
Shale & Sand	3570'		
Lime	3870'		
Shale & Lime	3942'		
Granite	3943'		
Rotary Total Depth	3943'		

RECEIVED
STATE CORPORATION COMMISSION

SEP 5 1963

CONSERVATION DIVISION
Wichita, Kansas

The above log is based on information provided by the drilling contractor; on the report of the geologist employed to supervise drilling operations; and upon analysis of a radioactivity log ran on subject well. To the best knowledge of the undersigned this represents a true and correct log of the formations penetrated in the drilling of the Klein No. 1 well.

WILCO OIL, INC. (formerly Max Cohen)

By James R. Daniels
James R. Daniels
Geological Engineer

State of Kansas)
) SS
County of Sedgwick)

Subscribed and sworn to before me, a notary public, in and for said county and state this 4th day of September, 1963

My Commission expires 11-18-66

Colleen Chapple
Colleen Chapple Notary Public