


STATE OF KANSAS
STATE CORPORATION COMMISSION

Form CP-4

All Information Completely
Required Affidavit
For Deliver Report to:
Conservation Division
State Corporation Commission
211 No. Broadway
Wichita, Kansas

WELL PLUGGING RECORD

NORTH

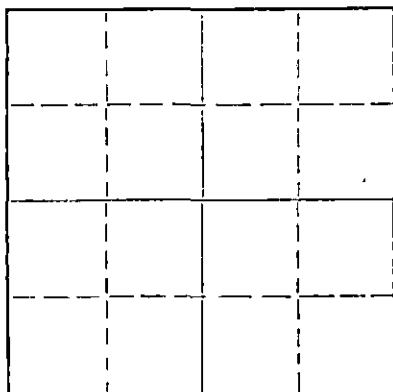

Locate well correctly on above
Section Plat

Edwards County. Sec. 2 Twp. 24S Rge. 16 XX (W)
Location as "NE/CNW/SW" or footage from lines SE NE SE
Lease Owner Wilco Oil, Inc.
Lease Name Klein Well No. 2
Office Address Box 13528, Phoenix, Arizona
Character of Well (completed as Oil, Gas or Dry Hole) Disposal-Input
Date well completed March 16 19 52
Application for plugging filed September 1 19 63
Application for plugging approved _____ 19 _____
Plugging commenced October 24 19 63
Plugging completed November 2 19 63
Reason for abandonment of well or producing formation Uneconomic

If a producing well is abandoned, date of last production September 19 59
Was permission obtained from the Conservation Division or its agents before plugging was commenced? Yes

Name of Conservation Agent who supervised plugging of this well Archie V. Elving
Producing formation Lansing-Kansas City Depth to top 3584 Bottom 3872 Total Depth of Well 3960 Feet
Show depth and thickness of all water, oil and gas formations.

OIL, GAS OR WATER RECORDS

CASING RECORD

FORMATION	CONTENT	FROM	TO	SIZE	PUT IN	PULLED OUT
<u>Lansing-Kansas City</u>	<u>Gas, oil, wtr.</u>	<u>3584</u>	<u>3872</u>	<u>8 5/8</u> <u>5 1/2</u>	<u>310</u> <u>3954</u>	<u>- -</u> <u>2302.25</u>

Describe in detail the manner in which the well was plugged, indicating where the mud fluid was placed and the method or methods used in introducing it into the hole. If cement or other plugs were used, state the character of same and depth placed, from _____ feet to _____ feet for each plug set.

Plug @ 3600' 5 sax cement 3600 to 3570'
Mud to 275' Rock Bridge 265' Run 5 sax cement 250'
Bailed Hole and run 20 sax cement 250 to 190'
Mud from 190 to 40' Rock and 10 sax cement 40' to base of cellar

RECEIVED
STATE CORPORATION COMMISSION

DEC 10 1963
12-10-63

CONSERVATION DIVISION
Wichita, Kansas

(If additional description is necessary, use BACK of this sheet)

Name of Plugging Contractor Glenn & Smith
Address Box 156, Ellinwood, Kansas

STATE OF KANSAS, COUNTY OF SEDGWICK, ss.

(employee of owner) or (owner or operator) of the above-described well, being first duly sworn on oath, says: That I have knowledge of the facts, statements, and matters herein contained and the log of the above-described well as filed and that the same are true and correct. So help me God.

(Signature) James R Daniels
James R. Daniels
308 Schweiter Building, Wichita, Kansas
(Address)

SUBSCRIBED AND SWORN TO before me this 6th day of December, 19 63

My commission expires November 18, 1966

Colleen Chapple
Colleen Chapple Notary Public.

LOG

Operator: Max Cohen & Armer Drilling Co., Inc.
(Now operated by Wilco Oil, Inc.)
Contractor: M. B. Armer (Unit Rig)
Drilling Commenced: 2/20/52
Drilling Completed: 3/10/52
Elevation: 2055 R.B.
2052 D.F.
2050 G.L.

Farm: Klein #2
Location: SE NE SE Sec. 2-24-16W
Edwards Co., Kansas
Casing: 8 5/8" at 310' w/ 225
sx. 5 1/2" at 3954' w/
175 sx.

Figures below indicate bottoms of formations:

Formation Tops (R.B. Meas.)

Sand	130'
Clay & Sand Stks.	205'
Shale & Shells	290'
Shale & Shells	310'
Redbed	460'
Sand	510'
Shale & Shells	610'
Redbed, shale & shells	950'
Anhydrite	995'
Shale & Shells	1290'
Sandy Redbed & Shells	1610'
Anhydrite & shale	1780'
Shale & Lime	2640'
Shale	2870'
Lime & Shale	3448'
Shale	3453'
Lime	3459'
Shale	3465'
Lime	3483'
Shale	3574'
Lime	3580'
Shale	3584'
Lime	3872'
Shale & Lime	3944'
Granite wash	3955'
Granite	3960'
Rotary Total Depth	3960'

Heebner	3448'
Toronto	3465'
Brown Lime	3574'
Lans. K. C.	3584'
Base K. C.	3872'
Granite wash	3944'
Granite	3955'

RECEIVED
STATE CORPORATION COMMISSION

SEP 5 1963

CONSERVATION DIVISION
Wichita, Kansas

The above log is based on information provided by the drilling contractor; on the report of the geologist employed to supervise drilling operations; and upon analysis of a radioactivity log run on subject well. To the best knowledge of the undersigned this represents a true and correct log of the formations penetrated in the drilling of the Klein No. 2 well.

WILCO OIL, INC. (formerly operated by
Max Cohen)

BY James R. Daniels
James R. Daniels
Geological Engineer

State of Kansas)
County of Sedgwick) ss

Subscribed and sworn to before me a notary public, in and for said county and state this 4th day of September, 1963

My commission expires 11-18-66

Colleen Chapple
Colleen Chapple - Notary Public