


WELL PLUGGING RECORD

Give All Information Completely
Make Required Affidavit
Mail or Deliver Report to:
Conservation Division
State Corporation Commission
211 No. Broadway
Wichita, Kansas

Edwards County, Sec. 7 Twp. 24 Rge. (E) 16 (W)

Location as "NE/CNW/SW" or footage from lines C SE NW
Lease Owner F. G. Holl
Lease Name Hawley Well No. A #1
Office Address 6427 E. Kellogg, Wichita, Kansas
Character of Well (completed as Oil, Gas or Dry Hole) oil
Date well completed _____ 19____
Application for plugging filed April 19 19 63
Application for plugging approved _____ 19____
Plugging commenced April 29 19 63
Plugging completed May 5 19 63
Reason for abandonment of well or producing formation depleted

NORTH

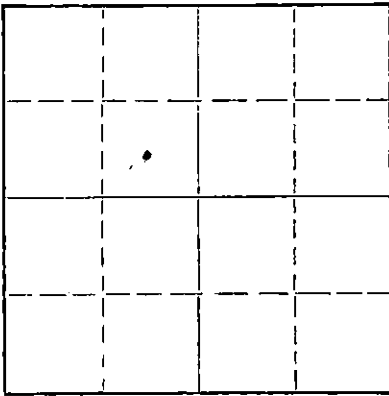

Locate well correctly on above
Section Plat

If a producing well is abandoned, date of last production _____ 19____
Was permission obtained from the Conservation Division or its agents before plugging was commenced? yes

Name of Conservation Agent who supervised plugging of this well W. L. Lackamp
Producing formation _____ Depth to top _____ Bottom _____ Total Depth of Well 4345 Feet
Show depth and thickness of all water, oil and gas formations.

OIL, GAS OR WATER RECORDS

CASING RECORD

FORMATION	CONTENT	FROM	TO	SIZE	PUT IN	PULLED OUT
		0	252	8 5/8	252	none
		0	4344	5 1/2	4344	3334.10

Describe in detail the manner in which the well was plugged, indicating where the mud fluid was placed and the method or methods used in introducing it into the hole. If cement or other plugs were used, state the character of same and depth placed, from _____ feet to _____ feet for each plug set.

Pushed plug with bailer to 4200', set 10' rock bridge. Mixed 5 sacks of cement and dumped at 4190'. Push plug to 225', set 10' rock bridge. Mixed 1 sack of cal-seal and 1 sack of cement and dumped at 215'. Let set over night. Bail hole down to 215', dump 19 sacks of cement. Filled with mud to 40', set 10' rock bridge and capped with 10 sacks of cement. Hole plugged 11 a.m.

RECEIVED
STATE CORPORATION COMMISSION

MAY 7 1963

5-7-63

Name of Plugging Contractor Pipe Pullers, Inc.
Address Box 486, Ellinwood, Kansas

CONSERVATION DIV.
Wichita, Kansas

STATE OF Kansas COUNTY OF Barton, ss.
Dean Wells

(employee of owner) or (owner or operator) of the above-described well, being first duly sworn on oath, says: That I have knowledge of the facts, statements, and matters herein contained and the log of the above-described well as filed and that the same are true and correct. So help me God.

(Signature) Dean Wells

Ellinwood, Kansas
(Address)

SUBSCRIBED AND SWORN TO before me this 6th day of May 19 63

George A. Meyer
Notary Public.

My commission expires Feb. 10, 1967

COPY


WELL LOG BUREAU—KANSAS GEOLOGICAL SOCIETY
508 East Murdock, Wichita, Kansas

Company. BRANINE & HOLL
Farm. C. E. Hawley "A" No. 1

SEC. 7 T. 24 R. 16W
SE SE NW

Total Depth. 4345'
Comm. 12-9-58 Comp. 12-24-58
Shot or Treated.
Contractor.
Issued. 4-18-59

County Edwards
KANSAS

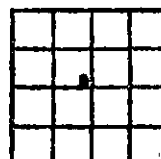

Elevation. 2092' RB

Production. 8 BOPD

CASING:

8 5/8" 252' cem w/200 sk.
5 1/2" 4344' cem w/100 sk.

Figures Indicate Bottom of Formations.

surface hole	100
shale	252
shale & shells	550
shale & sand	950
shells	1000
shale & shells	1365
shale	1515
shale & shells	2025
lime & shale	2190
lime	2195
lime & shale	2225
lost circulation	
cement	1765
shale & shells	2040
lime & shale	2140
lime	2150
lime & shale	2300
lime	2415
lime & shale	3670
lime	3730
lime & shale	3809
lime	4287
lime & shale	4340
lime	4345
Total Depth	

TOPS: SCOUT	
Anhydrite	1090
Heebner	3664
Toronto	3686
Douglas	3703
Brown Line	3791
Lansing	3798
Base Kansas City	4084
Mississippi	4244
Kinderhook	4278
Viola	4334

RECEIVED
STATE CORPORATION COMMISSION

FEB 22 1966

EXAMINATION DIVISION
Wichita, Kansas