


STATE OF KANSAS
STATE CORPORATION COMMISSION

WELL PLUGGING RECORD

Give All Information Completely
Make Required Affidavit
Mail or Deliver Report to:
Conservation Division
State Corporation Commission
800 Bittling Building
Wichita, Kansas

EDWARDS County. Sec. 7 Twp. 24 Rge. 16 (E) W (W)

Location as "NE/CNW/SW" or footage from lines SW SWC NE
Lease Owner Helmerich & Payne, Inc.
Lease Name Hawley Well No. 1
Office Address 1st National Bldg., Tulsa, Oklahoma
Character of Well (completed as Oil, Gas or Dry Hole) Dry Hole
Date well completed 10 - 19 - 55 19
Application for plugging filed 10 - 28 - 55 19
Application for plugging approved 10 - 24 - 55 19
Plugging commenced 10 - 19 - 55 19
Plugging completed 10 - 19 - 55 19
Reason for abandonment of well or producing formation Dry Hole

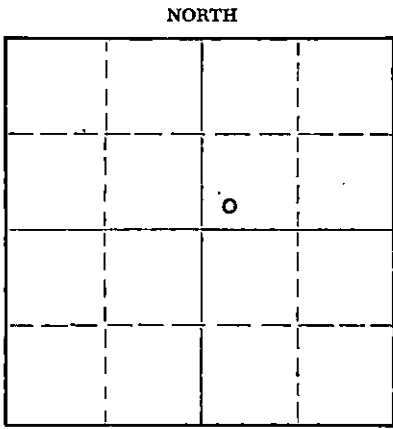

Locate well correctly on above Section Plat

If a producing well is abandoned, date of last production No production 19
Was permission obtained from the Conservation Division or its agents before plugging was commenced? Yes

Name of Conservation Agent who supervised plugging of this well Mr. M. A. Rives
Producing formation None Depth to top - Bottom - Total Depth of Well 4568' Feet
Show depth and thickness of all water, oil and gas formations.

OIL, GAS OR WATER RECORDS

CASING RECORD

FORMATION	CONTENT	FROM	TO	SIZE	PUT IN	PULLED OUT
Heebner Shale	-	3662				
Brown Lime	-	3787				
Lansing - K.C.	-	3794'				
Mississippi	-	4230				

Describe in detail the manner in which the well was plugged, indicating where the mud fluid was placed and the method or methods used in introducing it into the hole. If cement or other plugs were used, state the character of same and depth placed, from _____ feet to _____ feet for each plug set.

Mudded hole to 210', spotted 20 sacks cement. Mudded to 35' and spotted 10 sacks cement.

RECEIVED
STATE CORPORATION COMMISSION
OCT 29 1955
10-29-55

(If additional description is necessary, use BACK of this sheet)
Name of Plugging Contractor Harms - Burt Drilling Co.
Address P. O. Box 184, Great Bend, Kansas

STATE OF Kansas, COUNTY OF Sedgwick, ss.
Nathan E. Clark (employee of owner) or (owner or operator) of the above-described well, being first duly sworn on oath, says: That I have knowledge of the facts, statements, and matters herein contained and the log of the above-described well as filed and that the same are true and correct. So help me God.

(Signature) Nathan E. Clark
821 Central Bldg., Wichita, Kansas (Address)

SUBSCRIBED AND SWORN to before me this 28 th day of October, 1955

My commission expires March 30, 1957
Rosemary Penrose Notary Public.

PLUGGING
FOR SEC 7 T 24 R 16 W
PAGE 10 LINE 25

DRILLERS LOG

COMPANY: Helmerich and Payne, Inc.

LOCATION: SW SW NE
7 - 24 - 16W
Edwards Co., Kansas

FARM: Hawley

WELL NUMBER: 1

CASING: 215' of 8 5/8" w/ 200 sacks

ELEVATION: 2091' K.B.

COMMENCED: 10 - 1 - 55

CONTRACTOR: Harms-Burt Drlg. Co.

COMPLETED: 10 - 19 - 55

<u>FORMATION</u>	<u>DEPTH</u>	<u>FORMATION</u>	<u>DEPTH</u>
Sand & Clay	0 - 165	Lime & Shale	2940 - 3210
Shale	165 - 300	Lime	3210 - 3305
Sand & Shale	300 - 580	Lime & Shale	3305 - 3790
Sand	580 - 640	Lime	3790 - 4140
Red Bed & Shale	640 - 1100	Lime & Shale	4140 - 4233
Anhydrite	1100 - 1130	Chert	4233 - 4260
Shale & Red Bed	1130 - 1405	Lime, Shale, Chert	4260 - 4305
Shale & Shells w/ Salt	1405 - 1960	Conglomerate	4305 - 4358
Lime & Shale	1960 - 2215	Lime & Chert	4358 - 4455
Lime	2215 - 2580	Lime	4455 - 4545
Lime & Shale	2580 - 2875	Lime & Shale	4545 - 4568
Shale	2875 - 2940	Total Depth	4568

This is to certify that the above information is true and correct to the best of my knowledge.

Dutton E. Clark

Subscribed and sworn to before me this 28th day of October, 1955.

My commission expires March 30, 1957

Rosemary Penrose
Rosemary Penrose
Notary Public

RECEIVED
STATE CORPORATION COMMISSION
OCT 29 1955
CONSERVATION DIVISION
Wichita, Kansas

PLUGGING
PLK SEC 7 T 24 R 16W
BOOK PAGE 10 LINE 25