

STATE OF KANSAS
STATE CORPORATION COMMISSION

WELL PLUGGING RECORD

Give All Information Completely
Make Required Affidavit
Mail or Deliver Report to:
Conservation Division
State Corporation Commission
211 No. Broadway
Wichita, Kansas

Edwards County. Sec. 7 Twp. 24S Rge. 16W (E) (W)

Location as "NE/CNW/SW" or footage from lines. NE 1/4 SW SW NE 1/4

Lease Owner Branine-Holl

Lease Name Hawley Well No. 1

Office Address 6427 East Kellogg - Wichita, Kansas

Character of Well (completed as Oil, Gas or Dry Hole) _____

Date well completed _____ 19__

Application for plugging filed _____ 19__

Application for plugging approved _____ 19__


Plugging commenced February 1 19 57

Plugging completed February 6 19 57

Reason for abandonment of well or producing formation _____

If a producing well is abandoned, date of last production _____ 19__

Was permission obtained from the Conservation Division or its agents before plugging was commenced? Yes

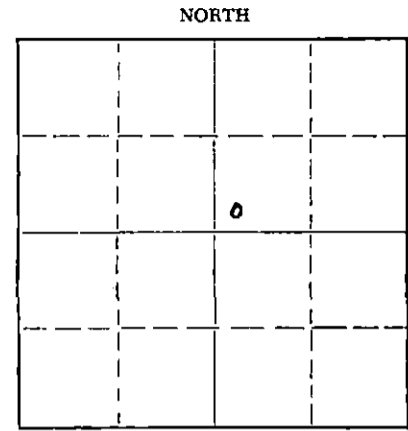

Locate well correctly on above Section Plat

Name of Conservation Agent who supervised plugging of this well Merle Rives

Producing formation _____ Depth to top _____ Bottom _____ Total Depth of Well 4416 Feet

Show depth and thickness of all water, oil and gas formations.

OIL, GAS OR WATER RECORDS

CASING RECORD

FORMATION	CONTENT	FROM	TO	SIZE	PUT IN	PULLED OUT
				8-5/8"	215'	None
				5-1/2"	4416'	2651'
				Hole was plugged back to 4260' and casing perforated from 4238'.		

Describe in detail the manner in which the well was plugged, indicating where the mud fluid was placed and the method or methods used in introducing it into the hole. If cement or other plugs were used, state the character of same and depth placed, from _____ feet to _____ feet for each plug set.

Filled the hole with sand from 4260' to 4225' and ran 5 sacks of cement. Pulled casing up to 1400' and circulated the hole with 40 sacks of jell mud. Set a 10' rock bridge at 210' and ran 20 sacks of cement on top. Mudded the hole to 35', set a 10' rock bridge and ran 10 sacks of cement on top. Plugging completed.

(If additional description is necessary, use BACK of this sheet)

Name of Plugging Contractor West Supply Co., Inc.

Address Chase, Kansas

STATE OF KANSAS, COUNTY OF SEDGWICK, ss. Robert L. Hoover (employee of owner) or (conservator) of the above-described

well, being first duly sworn on oath, says: That I have knowledge of the facts, statements, and matters herein contained and the log of the above-described well as filed and that the same are true and correct. So help me God.

(Signature) R. L. Hoover

(Address) _____

SUBSCRIBED AND SWORN to before me this 9th day of April 19 57

My commission expires August 5, 1957

Mary E. Lacey
Notary Public.
RECEIVED
STATE CORPORATION COMMISSION

PLUGGING
FILE SEC 7 T. 24 R. 16W
BOOK PAGE 137 L. E. 5

APR 10 1957
4-10-57
CONSERVATION DIVISION
Wichita, Kansas