


STATE OF KANSAS
STATE CORPORATION COMMISSION

WELL PLUGGING RECORD

Give All Information Completely
Make Required Affidavit
Mail or Deliver Report to:
Conservation Division
State Corporation Commission
800 Bittling Building
Wichita, Kansas

Stafford County, Sec. 24 Twp. 24 Rge. 15 (E) W (W)

Location as "NE/CNW%SW%" or footage from lines NW NW NE
Lease Owner Harms-Burt Drilling Company
Lease Name DeBusk Well No. 1
Office Address Box 184, Great Bend, Kansas
Character of Well (completed as Oil, Gas or Dry Hole) Dry Hole
Date well completed September 7 1954
Application for plugging filed September 7 1954
Application for plugging approved September 7 (orally) 1954
Plugging commenced September 7 1954
Plugging completed September 7 1954
Reason for abandonment of well or producing formation

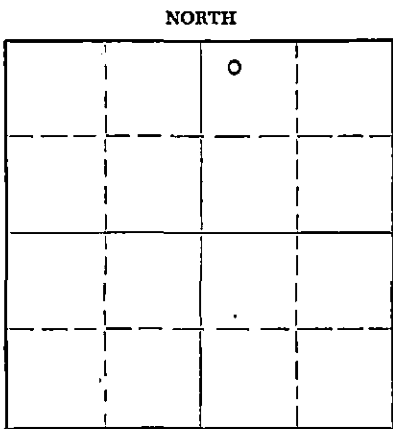

Locate well correctly on above
Section Plat

If a producing well is abandoned, date of last production 19
Was permission obtained from the Conservation Division or its agents before plugging was commenced? Yes

Name of Conservation Agent who supervised plugging of this well M.A. Rives, Pratt, Kansas
Producing formation Depth to top Bottom Total Depth of Well Feet
Show depth and thickness of all water, oil and gas formations.

OIL, GAS OR WATER RECORDS

CASING RECORD

FORMATION	CONTENT	FROM	TO	SIZE	PUT IN	PULLED OUT
Surface		0	210	8 5/8"	210	none

Describe in detail the manner in which the well was plugged, indicating where the mud fluid was placed and the method or methods used in introducing it into the hole. If cement or other plugs were used, state the character of same and depth placed, from feet to feet for each plug set.

Filled hole with heavy mud from 3810' total depth to 200'
Set plug at 200' and ran 20 sacks cement to 150'
Filled with heavy mud from 150' to 40'
Set plug at 40' and capped with 10 sacks cement.

(If additional description is necessary, use BACK of this sheet)

Name of Plugging Contractor Harms-Burt Drilling Co.
Address Box 184, Great Bend, Kansas

STATE OF Kansas, COUNTY OF Barton, ss.
ALLAN HARMS (employee of owner) or (owner or operator) of the above-described well, being first duly sworn on oath, says: That I have knowledge of the facts, statements, and matters herein contained and the log of the above-described well as filed and that the same are true and correct. So help me God.

(Signature) Allan Harms
Box 184 GREAT BEND, KANS.
(Address)

SUBSCRIBED AND SWORN TO before me this 23 day of September, 1954

Mary E Van Pelt
Notary Public.

My commission expires Jan. 20, 1958

24-2675-5 2-52-20M
PLUGGING
FILE SEC 24 T 24 R 15W
BOOK PAGE 13 LINE 2

9-24-54

Rec'd
9-24-54

DRILLER'S LOG

Company: Harms-Burt Drilling Company

NW NW-NE Sec. 24-24-15N
Stafford County, Kansas

Farm: DeBusk No. 1

Commenced: August 23, 1954 Completed: September 7, 1954 Elevation: 2009 RB

0 - 30	Clay and sand	3450 - 3600	Lime and shale
30 - 150	Sand	3600 - 3645	Lime
150 - 285	Shale and shells	3645 - 3745	Lime and shale
285 - 415	Red Bed and shells	3745 - 4020	Lime
415 - 480	Red Bed and sand	4020 - 4132	Lime and shale
480 - 945	Red Bed and shells	4132 - 4156	Lime, shale, & chert
945 - 965	Anhydrite	4156 - 4207	Cherty Cong.
965 - 1350	Shale and shells	4207 - 4235	Chert and lime
1350 - 1804	Shale, shells, and salt	4235 - 4252	Cherty Cong.
1804 - 1910	Lime and shale	4252 - 4272	Chert and lime
1910 - 1975	Lime	4272 - 4275	lime
1975 - 2120	Lime and shale	4275 - 4296	Sandy lime & green shale
2120 - 2220	Lime	4296 - 4315	Sand
2220 - 2920	Lime and shale	4315 - 4328	Lime and shale
2920 - 3090	Shale and lime	4328 - 4336	Sand
3090 - 3105	Lime	4336 - 4344	Lime and shale
3105 - 3265	Lime and shale	4344 - 4370	Lime
3265 - 3450	Lime	4370 - 4400	Lime
		4400	T. D.

Set 210 feet of 8 5/8" surface pipe, cemented with 250 sacks of common cement and 5 sacks of calcium chloride.

Tops: Anhydrite 945 ft.
Lansing 3600 ft.
Viola 4252 ft.
Simpson Sand 4296 ft.
Arbuckle 4348 ft.

Drill Stem Tests:

Simp No. 1 4297 - 4315 Open 1 hr. Shut in 20 min. 7 ft. drlg. mud.
IFP 5# FFP 5# BHP 30#

Ran Schlumberger.

Dry, plugged and abandoned.

Affidavit: State of Kansas)
County of Barton) SS.

I, Allan Harms, of the Harms-Burt Drilling Co.,
being first duly sworn on oath, state:

That I have knowledge of the facts, statements and matters herein contained
and that same are true and correct to the best of information and belief.

Signed Allan Harms

Subscribed and sworn to before me this 23 day of September, 1954.

Mary E Van Pelt
Notary Public

My Commission expires: 1-20-58

