

Give All Information Completely
Make Required Affidavit
Mail or Deliver Report to:
Conservation Division
State Corporation Commission
211 No. Broadway
Wichita, Kansas

WELL PLUGGING RECORD

Stafford County. Sec 24 Twp. 24 Rge. (E) 15 (W)

Location as "NE/CNW%SW%" or footage from lines SE NW SE

Lease Owner Hudson Petroleum Co.

Lease Name Suiter Well No. 1

Office Address 205 Central Bldg., Wichita, Kansas

Character of Well (completed as Oil, Gas or Dry Hole) Dry Hole

Date well completed Jan. 28 1964

Application for plugging filed Jan. 28 1964

Application for plugging approved Jan. 28 1964


Plugging commenced Jan. 28 1964

Plugging completed Jan. 28 1964

Reason for abandonment of well or producing formation Dry Hole

If a producing well is abandoned, date of last production 19

Was permission obtained from the Conservation Division or its agents before plugging was commenced? Yes

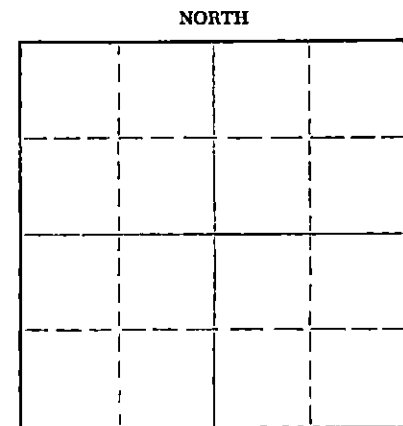

Locate well correctly on above Section Plat

Name of Conservation Agent who supervised plugging of this well Archie V. Elving, Pratt Ks.

Producing formation _____ Depth to top _____ Bottom _____ Total Depth of Well 4215 Feet

Show depth and thickness of all water, oil and gas formations.

OIL, GAS OR WATER RECORDS

CASING RECORD

FORMATION	CONTENT	FROM	TO	SIZE	PUT IN	PULLED OUT
				8-5/8"	251'	

Describe in detail the manner in which the well was plugged, indicating where the mud fluid was placed and the method or methods used in introducing it into the hole. If cement or other plugs were used, state the character of same and depth placed, from _____ feet to _____ feet for each plug set.

Set bottom plug @300' w/40 sx., top plug @40' w/10 sx., 2 sx. in rat hole.

RECEIVED
STATE CORPORATION COMMISSION

FEB 4 1964

2-4-64

CONSERVATION DIVISION
Wichita, Kansas

(If additional description is necessary, use BACK of this sheet)

Name of Plugging Contractor Navajo Drilling Co.

Address 205 Central Bldg., Wichita, Kansas

STATE OF Kansas, COUNTY OF Sedgwick, ss.
George R. Jones (employee of owner) ~~owner~~ of the above-described well, being first duly sworn on oath, says: That I have knowledge of the facts, statements, and matters herein contained and the log of the above-described well as filed and that the same are true and correct. So help me God.

(Signature) *George R. Jones*
205 Central Bldg., Wichita, Kansas
(Address)

SUBSCRIBED AND SWORN TO before me this 30th day of January, 1964

My commission expires July 19, 1964

Mildred Lindemann
Notary Public.

DRILLERS' LOG

Company: Hudson Petroleum Co.
 Contractor: Navajo Drilling Co.
 Farm: #1 Suiter, SE NW SE
 Sec. 24-24-15W
 Stafford Co., Kansas
 Commenced: 1/21/64
 Completed: 1/29/64
 Casing: 251' of 8-5/8" w/250 sx.

0	-	100	Sand
100	-	250	Shale & shells
250	-	551	Red bed & shale
551	-	955	Shale
955	-	985	Anhydrite
985	-	1495	Shale & shells
1495	-	1905	Shale
1905	-	2175	Ft. Riley lime
2175	-	2350	Lime & shale
2350	-	2575	Lime & shale
2575	-	2815	Shale w/lime streaks
2815	-	3050	Shale & Lime
3050	-	3220	Shale & lime
3220	-	3420	Topeka
3420	-	3550	Lime
3550	-	3612	Shale & lime
3612	-	3755	Shale w/lime
3755	-	3810	Lime & shale
3810	-	3882	Lime & shale
3882	-	3912	Lime
3912	-	3990	Lime
3990	-	4053	Lime & shale
4053	-	4124	Lime & shale
4124	-	4150	Lime
4150	-	4212	Lime & shale
4212	-	4215	Rotary total depth

RECEIVED
STATE CORPORATION COMMISSION

FEB 4 1964

CONSERVATION DIVISION
Wichita, Kansas

I, George R. Jones, do hereby certify that the above and foregoing is a true and correct copy of the log of the #1 Suiter, SE NW SE, Sec. 24-24-15W, Stafford County, Kansas, as reflected by the files of Navajo Drilling Co.

George R. Jones
GEORGE R. JONES

State of Kansas)
) ss:
County of Sedgwick)

Subscribed and sworn to before me, a Notary Public, in and for Sedgwick County, Kansas, this 3rd day of February, 1964.

My Commission Expires:
February 1, 1968

Barbara J. Layton
Barbara J. Layton, Notary Public