


STATE OF KANSAS
STATE CORPORATION COMMISSION

Give All Information Completely
Make Required Affidavit
Mail or Deliver Report to:
Conservation Division
State Corporation Commission
211 No. Broadway
Wichita, Kansas

WELL PLUGGING RECORD

NORTH

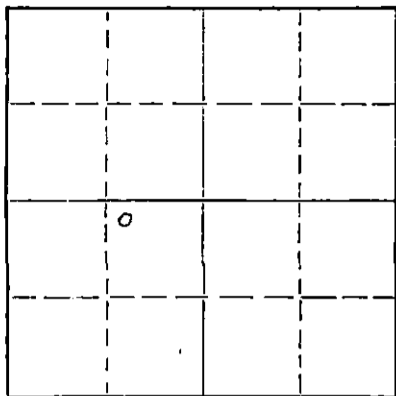

Locate well correctly on above
Section Plat

Stafford County, Sec. 29 Twp. 24S Rge. 15W (E) (W)
Location as "NE/CNW/SW" or footage from lines NW NE SW
Lease Owner Anschutz Drilling Co., Inc.
Lease Name Ackerman Well No. 2
Office Address 709 Union Natl. Bldg., Wichita, Kansas
Character of Well (completed as Oil, Gas or Dry Hole) Dry Hole
Date well completed November 23 1956
Application for plugging filed November 23 1956
Application for plugging approved November 23 1956
Plugging commenced November 23 1956
Plugging completed November 23 1956
Reason for abandonment of well or producing formation Dry

If a producing well is abandoned, date of last production 19
Was permission obtained from the Conservation Division or its agents before plugging was commenced? Yes

Name of Conservation Agent who supervised plugging of this well R. M. Brundage
Producing formation _____ Depth to top _____ Bottom _____ Total Depth of Well 4313 Feet
Show depth and thickness of all water, oil and gas formations.

OIL, GAS OR WATER RECORDS

CASING RECORD

FORMATION	CONTENT	FROM	TO	SIZE	PUT IN	PULLED OUT
				8-5/8"	223'	

Describe in detail the manner in which the well was plugged, indicating where the mud fluid was placed and the method or methods used in introducing it into the hole. If cement or other plugs were used, state the character of same and depth placed, from _____ feet to _____ feet for each plug set.
Ran plug and put in 81 sacks cement and 200# calcium chloride.

RECEIVED
STATE CORPORATION COMMISSION
2-7-56
DEC 7 1956
CONSERVATION DIVISION
Wichita, Kansas

(If additional description is necessary, use BACK of this sheet)
Name of Plugging Contractor Anschutz Drilling Co., Inc.
Address 709 Union Natl. Bldg., Wichita, Kansas

STATE OF Kansas, COUNTY OF Sedgwick, ss.
Shirley Salley (employee of owner) or (owner or operator) of the above-described well, being first duly sworn on oath, says: That I have knowledge of the facts, statements, and matters herein contained and the log of the above-described well as filed and that the same are true and correct. So help me God.

(Signature) Shirley Salley
709 Union Natl. Bldg., Wichita, Kansas
(Address)

SUBSCRIBED AND SWORN TO before me this 28th day of November, 19 56
Kenneth R. Swenson
Kenneth R. Swenson Notary Public.

My commission expires April 27, 1959

PLUGGING
FILE SEC. 29 T. 24 R. 15W
BOOK PAGE 119 LINE 17

DRILLERS' LOG

#2 ACKERMAN
NW NE SW Sec. 29-24S-15W
Stafford County, Kansas

FROM	TO	
0	10	Soil
10	80	Sand
80	155	Sand and gravel
155	224	Shale and shells
224	300	Shale
300	1015	Red bed
1015	1030	Anhydrite
1030	1294	Shale and lime streaks
1294	1675	Shale and shells
1675	2510	Lime and shale
2510	2625	Lime
2625	2940	Lime and shale
2940	3365	Shale and lime
3365	3635	Lime
3635	3786	Shale and lime
3786	4056	Lime
4056	4115	Shale and lime
4115	4212	Lime and shale
4212	4267	Mississippi chert
4267	4303	Kinderhook shale
4303	4313	Lime and shale
	4313	Total Depth

COMMENCED: 11/11/56

COMPLETED: 11/23/56

CASING RECORD:
Set 223' of 8-5/8"
surface casing with 175
sacks cement, 200# jel,
200# calcium chloride

STATE OF KANSAS)
) SS
COUNTY OF SEDGWICK)

I hereby affirm that the above and foregoing is a true and correct copy of the formations encountered on the #2 Ackerman, NW NE SW of Section 29-24S-15W, Stafford County, Kansas, as reflected by the daily drilling reports.

ANSCHUTZ DRILLING CO. INC.

By: *Shirley Salley*
Shirley Salley

Subscribed and sworn to before me this 27th day of November, 1956.

My Commission Expires: April 27, 1959

Kenneth R. Swenson
Kenneth R. Swenson, Notary Public

RECEIVED
STATE CORPORATION COMMISSION

DEC 7 - 1956

CONSERVATION DIVISION
Wichita, Kansas

PLUGGING
FILE SEC. 29 T. 24 R. 15W
BOOK PAGE 119 LINE 17