

STATE OF KANSAS
STATE CORPORATION COMMISSION


WELL PLUGGING RECORD

Give All Information Completely
Make Required Affidavit
Mail or Deliver Report to:
Conservation Division
State Corporation Commission
800 Biting Building
Wichita, Kansas

Stafford County, Sec. 36 Twp. 21 Rge. (E) 15 (W)

Location as "NE/CNW/SW" or footage from lines SE/NW/NW
Lease Owner Wilcox-Henry; Durbin Bond & Co., Inc.; Lewis Drlg. Co.
Lease Name Satterlee Well No. #2
Office Address 607 Union National Bank Bldg., Wichita, Kansas
Character of Well (completed as Oil, Gas or Dry Hole) Dry Hole
Date well completed 5-11-19 56
Application for plugging filed 5-11-19 56
Application for plugging approved 5-11-19 56
Plugging commenced 5-11-19 56
Plugging completed 5-11-19 56
Reason for abandonment of well or producing formation _____

NORTH

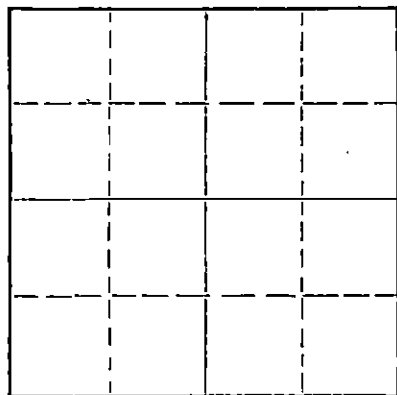

Locate well correctly on above
Section Plat

If a producing well is abandoned, date of last production _____ 19____
Was permission obtained from the Conservation Division or its agents before plugging was commenced? Yes

Name of Conservation Agent who supervised plugging of this well R. M. Burndege
Producing formation _____ Depth to top _____ Bottom _____ Total Depth of Well 3439 Feet
Show depth and thickness of all water, oil and gas formations.

OIL, GAS OR WATER RECORDS

CASING RECORD

FORMATION	CONTENT	FROM	TO	SIZE	PUT IN	PULLED OUT
				8 5/8"	200'	-0-

Describe in detail the manner in which the well was plugged, indicating where the mud fluid was placed and the method or methods used in introducing it into the hole. If cement or other plugs were used, state the character of same and depth placed, from _____ feet to _____ feet for each plug set.

Sun Oilwell Cementing, Inc. put 1/3 Sx hulls in casing,
put 2 plugs on top of hulls & pumped in 100 Sx cement slow.

(If additional description is necessary, use BACK of this sheet)

Name of Plugging Contractor Lewis Drilling Company
Address _____

STATE OF KANSAS, COUNTY OF SEDGWICK, ss.
J. Fred Hambright

(employee of owner) or (owner or operator) of the above-described well, being first duly sworn on oath, says: That I have knowledge of the facts, statements, and matters herein contained and the log of the above-described well as filed and that the same are true and correct. So help me God.

(Signature) J. Fred Hambright
607 Union National Bank Bldg. Wichita, Kansas
(Address)

SUBSCRIBED AND SWORN TO before me this 4th day of June, 19 56.

Arthur P. Derrington
(Arthur R. Derrington) Notary Public.

My commission expires August 20, 1956

PLUGGING
FILE SEC. 36 T. 24 R. 15W
BOOK PAGE 61 LINE 4

REC-
STATE OF
6-6-56

CONSER
STATE


WELL LOG

COMPANY Wilcox-Henry, Durbin Bond & Co., Inc.,
Lewis Drilling Company
FARM Satterlee NO. 2

SEC. 36 T. 24 R. 15W
LOC. SE/NW/NW

TOTAL DEPTH 3439'
COMM. 4-20-56 COMP. 5-11-56
SHOT OR TREATED
CONTRACTOR Lewis Drilling Company
ISSUED

COUNTY Stafford
KANSAS

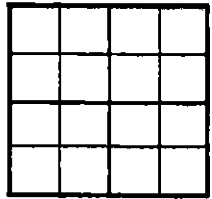

ELEVATION 2010 D.F.

PRODUCTION

CASING

20 10
15 X 8 5/8" - 200'
12 6
13 X

FIGURES INDICATE BOTTOM OF FORMATIONS

0 - 170 S Sand
170 - 330 Blue Shale
330 - 940 Red Beds
940 - 980 Anhydrite
980 - 1335 Shale and Shells
1335 - 3439 Shale and Lime
3439' T. D.

State of KANSAS }
County of SEDGWICK } ss:

PLUGGING
FILE SEC. 36 T. 24 R. 15W
BOOK PAGE 61 LINE 4

I, J. Fred Hambright of the Lewis Drilling Company

upon oath state that the above and foregoing is a true and correct copy of the log of the Satterlee #2 well.

RECEIVED
COMMISSION

JUN 6 X 1956

CONSERVATION DIVISION

Subscribed, and sworn to before me this 11th day of June 19 56

My Commission Expires: August 20, 1956

Arthur R. Derrington
NOTARY PUBLIC
(Arthur R. Derrington)