


STATE OF KANSAS
STATE CORPORATION COMMISSION

WELL PLUGGING RECORD

Give All Information Completely
Make Required Affidavit
Mail or Deliver Report to
Conservation Division
State Corporation Comm.
245 North Water
Wichita, KS 67202

Stafford County, Sec. 16 Twp. 24S Rge. 15W E/W
Location as "NE/CNW 1/4 SW 1/4" or footage from lines _____
NE NW SW
Lease Owner Murfin Drilling Company
Lease Name Smith Well No. 1
Office Address 617 Union Center, Wichita, Kansas 67202
Character of Well (Completed as Oil, Gas or Dry Hole) _____
Dry hole

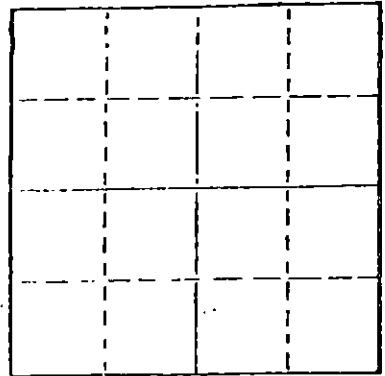

Locate well correctly on above
Section Plat

Date Well completed May 4, 1977
Application for plugging filed May 4, 1977
Application for plugging approved May 4, 1977
Plugging commenced May 4, 1977
Plugging completed May 4, 1977
Reason for abandonment of well or producing formation _____
Dry hole

If a producing well is abandoned, date of last production _____
19 _____

Was permission obtained from the Conservation Division or
its agents before plugging was commenced? yes

Name of Conservation Agent who supervised plugging of this well J. W. Metz
Producing formation _____ Depth to top _____ Bottom _____ Total Depth of Well 4259'
Show depth and thickness of all water, oil and gas formations.

OIL, GAS OR WATER RECORDS

CASING RECORD

FORMATION	CONTENT	FROM	TO	SIZE	PUT IN	PULLED OUT
				8-5/8"	525'	-

Describe in detail the manner in which the well was plugged, indicating where the mud fluid
was placed and the method or methods used in introducing it into the hold. If cement or other
plugs were used, state the character of same and depth placed, from _____ feet to
_____ feet for each plug set.

Mud to 550', 35 sacks cement
Mud to 40', plug, 1/2 sack hulls, 15 sacks cement
5 sacks cement in rat hole

RECEIVED
STATE CORPORATION COMMISSION
5-11-77
MAY 11 1977

CONSERVATION DIVISION
Wichita, Kansas

(If additional description is necessary, use BACK of this sheet)

Name of Plugging Contractor _____

STATE OF KANSAS COUNTY OF SEDGWICK, ss.
Don Gardner (employee of owner) or ~~owner or operator~~

of the above-described well, being first duly sworn on oath, says: That I have knowledge of
the facts, statements, and matters herein contained and the log of the above-described well
as filed and that the same are true and correct. So help me God.

(Signature) [Signature]
Suite 250, 200 West Douglas, Wichita, Kansas
(Address)

SUBSCRIBED AND SWORN TO before me this 10th day of May, 1977

Kathleen E. Durbin
Notary Public.

My commission expires January 4, 1981

DRILLERS LOG

#1 SMITH
NE NW SW Section 16-24S-15W
Stafford County, Kansas

OPERATOR:

MURFIN DRILLING COMPANY
617 Union Center
Wichita, Kansas 67202

CONTRACTOR:

DUNNE-GARDNER PETROLEUM, INC.
Suite 250, 200 West Douglas
Wichita, Kansas 67202

COMMENCED:

April 21, 1977

COMPLETED:

May 4, 1977

CASING RECORD:

8-5/8" @ 525' w/325 sx

<u>FROM</u>	<u>TO</u>
0	120
120	530
530	987
987	1900
1900	2025
2025	2055
2055	2370
2370	2555
2555	3365
3365	4025
4025	4075
4075	4140
4140	4190
4190	4220
4220	4259
4259	

<u>DESCRIPTION</u>
Clay and sand
Shale and shells
Red bed
Anhydrite
Shale and lime
Shale and shells
Shale and lime
Broken lime
Lime and shale
Lime
Cherty lime
Lime
Cherty lime
Lime
Cherty lime
Rotary total depth

RECEIVED
STATE CORPORATION COMMISSION

MAY 11 1977

CONSERVATION DIVISION
Wichita, Kansas


STATE OF KANSAS)
) ss
COUNTY OF SEDGWICK)

I hereby certify that the above is a true and correct log to the best of my knowledge and belief.


Don Gardner

Subscribed and sworn to before me this 10th day of May, 1977.

My appointment expires:
January 4, 1981

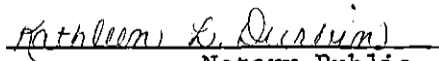
Notary Public