

STATE OF KANSAS
STATE CORPORATION COMMISSION

WELL PLUGGING RECORD

Give All Information Completely
Make Required Affidavit
Mail or Deliver Report to:
Conservation Division
State Corporation Commission
800 Bittling Building
Wichita, Kansas

Stafford County. Sec. 27 Twp. 24 Rge. (E) 15(W)

Location as "NE/CNW/SW" or footage from lines NE NW NE

Lease Owner Westgate-Greenland Oil Company

Lease Name Campbell Well No. 1

Office Address 1009 Central Building, Wichita, Kansas

Character of Well (completed as Oil, Gas or Dry Hole) dry hole

Date well completed March 31, 1953 19

Application for plugging filed March 31, 1953 (orally) 19

Application for plugging approved March 31, 1953 (Orally) 19


Plugging commenced March 31, 1953 19

Plugging completed March 31, 1953 19

Reason for abandonment of well or producing formation _____

If a producing well is abandoned, date of last production _____ 19

Was permission obtained from the Conservation Division or its agents before plugging was commenced? Yes

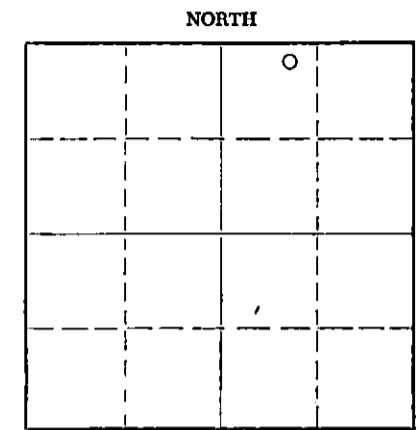

Locate well correctly on above Section Plat

Name of Conservation Agent who supervised plugging of this well C. D. Stough, Great Bend, Kansas

Producing formation _____ Depth to top _____ Bottom _____ Total Depth of Well _____ Feet

Show depth and thickness of all water, oil and gas formations.

OIL, GAS OR WATER RECORDS

CASING RECORD

FORMATION	CONTENT	FROM	TO	SIZE	PUT IN	PULLED OUT
Surface		0	200	8 5/8"	200	none

Describe in detail the manner in which the well was plugged, indicating where the mud fluid was placed and the method or methods used in introducing it into the hole. If cement or other plugs were used, state the character of same and depth placed, from _____ feet to _____ feet for each plug set.

Filled hole with heavy mud from 4518 to 200 feet
Set plug at 200 feet and ran 20 sacks cement to 140 feet
Filled with heavy mud from 140 to 35 feet
Set plug at 35 feet and ran 10 sacks cement to cellar

Revised 4-4-53

(If additional description is necessary, use BACK of this sheet)

Name of Plugging Contractor Westgate Drilling Corporation
Address 1009 Central Building, Wichita 2, Kansas


STATE OF Kansas, COUNTY OF Sedgwick, ss.
G. E. Bitler (employee of owner) or (owner or operator) of the above-described

well, being first duly sworn on oath, says: That I have knowledge of the facts, statements, and matters herein contained and the log of the above-described well as filed and that the same are true and correct. So help me God.

(Signature) G. E. Bitler
1009 Central Building, Wichita, Ks
(Address)

SUBSCRIBED AND SWORN TO before me this 3rd day of April, 1953

My commission expires May 25, 1953. Esther Russell Notary Public.

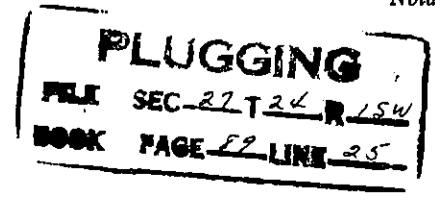

DRILLER'S LOG

COMPANY: Westgate-Greenland Oil Company
 CONTRACTOR: Westgate Drilling Corporation
 FARM: Campbell #1, NE NW NE 27-24S-15W
 Stafford County, Kansas
 COMMENCED: March 14, 1953
 COMPLETED: March 31, 1953
 ELEVATION: 2027 DF

0	to	35	Sandy clay
35	to	130	Sand
130	to	330	Shale and shells
330	to	485	Red Bed
485	to	515	Sand
515	to	675	Red bed-shale-shells
675	to	989	Red bed
989	to	1020	Anhydrite
1020	to	1500	Shale and shells
1500	to	1650	Shale, salt and shells
1650	to	1830	Shale and shells
1830	to	2000	Lime and shale
2000	to	2245	Lime
2245	to	3475	Lime and shale
3475	to	3627	Lime
3627	to	3770	Lime and shale
3770	to	4031	Lime
4031	to	4070	Shale-lime-chert
4070	to	4171	Lime and shale
4171	to	4180	Shale and sand
4180	to	4257	Lime and shale
4257	to	4261	Chert
4261	to	4276	Shale
4276	to	4295	Lime-shale and chert
4295	to	4364	Shale w/chert
4364	to	4431	Lime-shale-chert
4431	to	4493	Lime and shale
4493	to	4518	Arbuckle Lime
		4518	T. D. (RB)

PLUGGING
 FILE SEC 2724 R 15W
 BOOK PAGE 89 LINE 23

RECEIVED
 STATE CORPORATION COMMISSION
 APR 4 1953
 CONSERVATION DIVISION
 Wichita, Kansas

Set 200 feet of 8 5/8" 24# surface pipe. Cemented with 225 sacks cement and 3 sacks calcium chloride

Drill Stem Tests:

1. 4158-78, open 1 hr, rec. 25' mud, gas in pipe 900', 540# BHP.
2. 4236-59, open 1 hour, rec. 45' slightly oil and gas cut mud, 20' heavily oil & gas cut mud, trace free oil. 750# BHP.

TOPS:	Anhydrite	987	Lansing	3763	Kinderhook	4156
	Heebner	3611	Base KC	4026	Viola Dolo	4235
	Brown Ls	3751	Mississippi	4137	Simpson	4446
					Arbuckle	4491

Schlumberger run
 DRY, PLUGGED AND ABANDONED

C E R T I F I C A T E

I, Harold A. Burt, do hereby certify that the above and foregoing is a true and correct copy of the log of the Campbell #1, NE NW NE 27-24-15W, Stafford County, Kansas as reflected by files of the Westgate-Greenland Oil Company.

Harold A. Burt
 Harold A. Burt

Subscribed and sworn to before me, a Notary Public, within and for Sedgwick County, Kansas, this 3rd day of April 1953.

Esther Unsell
 Esther Unsell, Notary Public

My commission expires
 May 25, 1953