

STATE OF KANSAS
STATE CORPORATION COMMISSION

Form CP-4


All Information Completely
Required Affidavit
or Deliver Report to:
Conservation Division
State Corporation Commission
211 No. Broadway
Wichita, Kansas

WELL PLUGGING RECORD

Stafford County. Sec. 27 Twp. 24 Rge. 15 (E) W (W)

Location as "NE/CNW/SW" or footage from lines SW-SE-SW
Lease Owner Fender Pipe & Supply
Lease Name Addie Campbell Well No. 1
Office Address Russell, Kansas
Character of Well (completed as Oil, Gas or Dry Hole) _____
Date well completed _____ 19____
Application for plugging filed _____ 19____
Application for plugging approved _____ 19____
Plugging commenced Aug. 19 1963
Plugging completed Aug. 24 1963
Reason for abandonment of well or producing formation _____

NORTH

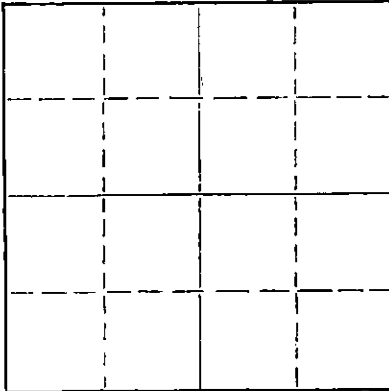

Locate well correctly on above
Section Plat

If a producing well is abandoned, date of last production _____ 19____
Was permission obtained from the Conservation Division or its agents before plugging was commenced? Yes

Name of Conservation Agent who supervised plugging of this well Elving
Producing formation _____ Depth to top _____ Bottom _____ Total Depth of Well 4241 Feet
Show depth and thickness of all water, oil and gas formations.

OIL, GAS OR WATER RECORDS

CASING RECORD

FORMATION	CONTENT	FROM	TO	SIZE	PUT IN	PULLED OUT

Describe in detail the manner in which the well was plugged, indicating where the mud fluid was placed and the method or methods used in introducing it into the hole. If cement or other plugs were used, state the character of same and depth placed, from 4241 feet to surface feet for each plug set.

Sanded up to 4220' dump 6 sacks of cement on bottom. Pulled pipe from hole, muded up to 300' dump 6 Yds. of concret in hole, Cement filled up to bottom of cellor.

RECEIVED
STATE CORPORATION COMMISSION
10-16-63
OCT 16 1963

CONSERVATION DIVISION
Wichita, Kansas

(If additional description is necessary, use BACK of this sheet)
Name of Plugging Contractor Barnes & Sons Pipe Pulling Co.
Address P.O. Box 313 Russell, Kansas

STATE OF Kansas, COUNTY OF Russell, ss.
Allen J. Fender (employee of owner) or (owner or operator) of the above-described well, being first duly sworn on oath, says: That I have knowledge of the facts, statements, and matters herein contained and the log of the above-described well as filed and that the same are true and correct. So help me God.

(Signature) Allen J. Fender
Russell, Kansas (Address)

SUBSCRIBED AND SWORN TO before me this 16th day of September, 1963

My commission expires June 21st, 1966

Peggy J. Anderson
Notary Public.