


STATE OF KANSAS
STATE CORPORATION COMMISSION
Give All Information Completely
Make Required Affidavit
Mail or Deliver Report to:
Conservation Division
State Corporation Commission
211 No. Broadway
Wichita, Kansas

WELL PLUGGING RECORD

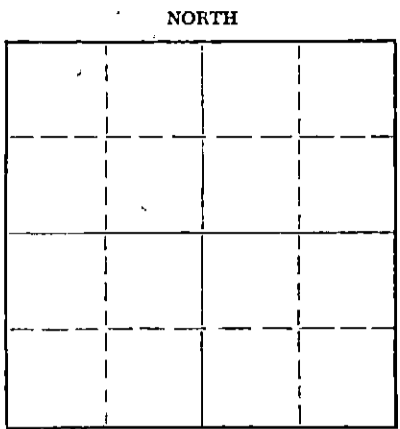

Locate well correctly on above Section Plat

Stafford County. Sec. 36 Twp. 24 Rge. (E) 15 (W)
Location as "NE/CNW/SW" or footage from lines E/2 E/2 NE
Lease Owner White Hawk Oil Company
Lease Name Satterlee "A" Well No. 2
Office Address P. O. Box 1150, Great Bend, Kansas 67530
Character of Well (completed as Oil, Gas or Dry Hole) Salt Water Disposal
Date well completed July 21, 1957 19
Application for plugging filed November 26, 1979 19
Application for plugging approved November 28, 1979 19
Plugging commenced December 6, 1979 19
Plugging completed December 6, 1979 19
Reason for abandonment of well or producing formation In operative as a salt water disposal well.
If a producing well is abandoned, date of last production _____ 19
Was permission obtained from the Conservation Division or its agents before plugging was commenced? Yes

Name of Conservation Agent who supervised plugging of this well Bill Owen
Producing formation _____ Depth to top _____ Bottom _____ Total Depth of Well 4497 Feet
Show depth and thickness of all water, oil and gas formations.

OIL, GAS OR WATER RECORDS				CASING RECORD		
FORMATION	CONTENT	FROM	TO	SIZE	PUT IN	PULLED OUT
				8-5/8"	242	None
				5-1/2"	4462	None
				2-7/8"	4450	261 feet

Describe in detail the manner in which the well was plugged, indicating where the mud fluid was placed and the method or methods used in introducing it into the hole. If cement or other plugs were used, state the character of same and depth placed, from _____ feet to _____ feet for each plug set.

Pumped flag down 5 1/2" to a hole at 191 feet.
Pumped 50 sacks 50-50 pozmix down 5 1/2" casing at 150#.
Pumped 20 sacks gel down 8-5/8" casing at 200#.
Pumped 75 sacks 50-50 pozmix down 8-5/8" at 200#.
Cement to surface, 5 1/2" and 8-5/8".
Cut off 8-5/8" and 5 1/2" 4 feet below ground level, weld on cap and fill in cellar

RECEIVED
STATE CORPORATION COMMISSION
12-10-79
DEC 10 1979
CONSERVATION DIVISION
Wichita, Kansas


(If additional description is necessary, use BACK of this sheet)

Name of Plugging Contractor _____
Address _____

STATE OF Kansas, COUNTY OF Barton, ss.
Robert E. Lundberg (employee of owner) or ~~owner or operator~~ of the above-described well, being first duly sworn on oath, says: That I have knowledge of the facts, statements, and matters herein contained and the log of the above-described well as filed and that the same are true and correct. So help me God.

(Signature) Robert E. Lundberg
P. O. Box 1150, Great Bend, Kansas 67530
(Address)

SUBSCRIBED AND SWORN TO before me this 7th day of December, 19 79

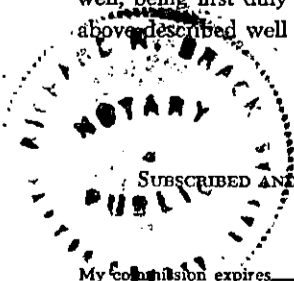

Richard R. Beach
Notary Public.

My Commission expires August 6, 1983

