

WELL PLUGGING RECORD

OR


FORMATION PLUGGING RECORD

Strike out upper line when reporting plugging of formations.

STATE OF KANSAS STATE CORPORATION COMMISSION

Give All Information Completely Make Required Affidavit Mail or Deliver Report to: Conservation Division State Corporation Commission 800 Bitting Building Wichita, Kansas

Reno County. Sec. 31 Twp. 22S Rge. 9 (B) (W) Location as "NE 1/4 NW 1/4 SW 1/4" or footage from lines 5/2 NW NW Lease Owner Stanolind Oil and Gas Company Lease Name A. Schweizer Well No. 1 Office Address Box 1654, Oklahoma City, Oklahoma Character of Well (completed as Oil, Gas or Dry Hole) Oil Date well completed 11-23 1942 Application for plugging filed 5-3 1950 Application for plugging approved 5-4 1950 Plugging commenced 5-28 1950 Plugging completed 6-3 1950 Reason for abandonment of well or producing formation Depleted If a producing well is abandoned, date of last production March 1950 Was permission obtained from the Conservation Division or its agents before plugging was commenced? Yes

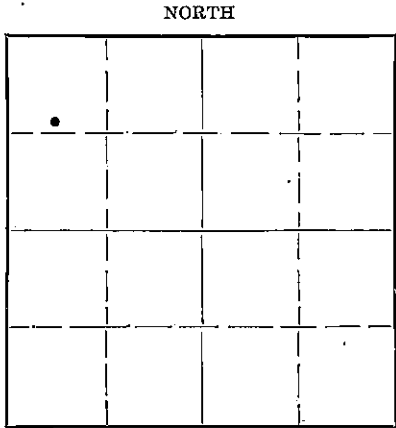

Locate well correctly on above Section Plat

Name of Conservation Agent who supervised plugging of this well Ruel Durkee Producing formation Viola Lime Depth to top 3674 Bottom 3711 Total Depth of Well 3711 Feet Show depth and thickness of all water, oil and gas formations.

OIL, GAS OR WATER RECORDS

CASING RECORD

Table with 7 columns: Formation, Content, From, To, Size, Put In, Pulled Out. Row 1: Viola Lime, Oil, 3674, 3711, 13" 7", 265' 3698', None 3030'

Describe in detail the manner in which the well was plugged, indicating where the mud fluid was placed and the method or methods used in introducing it into the hole. If cement or other plugs were used, state the character of same and depth placed, from... feet to... feet for each plug set.

Dumped G/ Rock 3711' - 3692' 6 Sx. Cement 3692' - 3667' Pumped Hvy. Mud 3667' - 265' Dumped G/Rock 265' - 253' 25 Sx. Cement 253' - 220' Pumped Hvy. Mud 220' - 20' 8 Sx. Cement 20' - 8' Cellar 8' - 0'

6-10-50

RECEIVED Conservation Div. JUN 10 1950 STATE CORPORATION COMMISSION KANSAS

(If additional description is necessary, use BACK of this sheet)

Correspondence regarding this well should be addressed to G. A. Younie Address P. O. Box 7, Ellinwood, Kansas

STATE OF Kansas COUNTY OF Barton ss. G. A. Younie (employee of owner) or (owner or operator) of the above-described well, being first duly sworn on oath, says: That I have knowledge of the facts, statements, and matters herein contained and the log of the above-described well as filed and that the same are true and correct. So help me God.


(Signature) G. A. Younie Field Superintendent

P. O. Box 7, Ellinwood, Kansas (Address)

SUBSCRIBED AND SWORN to before me this 9th day of June 1950

G. H. Rader Notary Public

My commission expires November 14, 1953

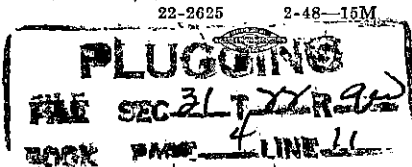

FORMATION RECORD

DESCRIBE EACH FORMATION DRILLED. INDICATE THICKNESS, CONTENT AND WHETHER DRY, OR OIL, GAS, OR WATER BEARING.

FORMATION	TOP	BOTTOM	FORMATION	TOP	BOTTOM
Cellar	0'	6'	10/1		
Sand and shale	6	110	Broken Shale	3601	3678
Shale and shells	110	260	7/5, 10/5, 10/5, 10/5,		
Red Rock and shells	260	335	9/5, 10/5, 10/5, 10/5,		
Anhydrite	335	357	11, 10, 8, 10, 9, 9, 11,		
Red Rock Shale and shells	357	1000	9, 9, 10, 11, 11, 10, 10,		
Salt shale and shells	1000	1325	10, 11, 9, 9, 11, 16, 15,		
Shale and lime shells	1325	1385	13, 10, 9, 8, 7, 7, 10, 9,		
Broken lime	1385	1510	9, 9, 8, 8, 9, 9, 7, 13, 12		
Shale and sharp lime	1510	1635			
Broken lime and Shale	1635	2142			
Lime and shale	2142	2205			
Shale and shells	2205	2430			
Broken lime	2430	2490			
Lime and shale	2490	2821			
Lime and shale	2821	3082			
Shale and shells	3082	3108			
Various colored shales					
occasional lime shells	3108	3176			
Broken lime	3176	3274			
Lime with soft porous					
strips	3274	3296			
Lime	3296	3503			
Lime and chert streaks	3503	3525			
Lime	3525	3552			
Shale lime shells and					
chert streaks	3552	3601			
Broken shale	3601	3674			
Lime	3674	3711			
Total Depth		3711			
Shale and shells - 7/5,					
4/3,	3100	3108			
Various colored shales					
occasional lime shells	3108	3176			
4/2, 5/5, 6/5, 5/5, 6/5,					
7/5, 6/5, 7/5, 5/5, 7/5,					
5/5, 5/5, 6/5, 6/5, 8/1,					
Broken lime, 8/4, 6/5,	3176	3274			
5/5, 5/5, 6/5, 6/5, 7/5,					
6/5, 7/5, 9/5, 9/5, 10/5,					
11/5, 14/5, 14/5, 11/5,					
12/5, 9/5, 10/5, 9/4,					
Lime with soft porous	3274	3296			
strips - 9/1, 5/5, 4/5,					
7/5, 8/5, 12/5, 10/1					
Lime 10/4, 10/5, 10/5,	3296	3503			
10/5, 10/5, 10/5, 10/5,					
7/5, 10/5, 7/5, 9/5, 9/5,					
7/5, 7/5, 6/5, 6/5, 7/5,					
8/5, 9/5, 8/5, 7/5, 9/5,					
15/5, 7/5, 7/5, 7/5, 6/5,					
7/5, 14/5, 14/5, 12/5, 13/5,					
14/5, 15/5, 10/5, 11/5,					
12/5, 9/5, 10/5, 11/5,					
9/3,					
Lime and chert streaks	3503	3525			
9/2, 3/5, 4/5, 4/5, 4/5,					
Lime - 8/5, 14/5, 14/5,	3525	3552			
2/5, 9/5, 8/5, 9/2,					
Shale lime shells and	3552	3601			
chert streaks					
9/3, 8/5, 8/5, 9/5, 9/5,					
8/5, 9/5, 7/5, 7/5, 8/5,					

PLUGGING
 FILE SEC-31 T. V. R. 92
 BOOK PAGE 4 LINE 11