


STATE OF KANSAS  
STATE CORPORATION COMMISSION

WELL PLUGGING RECORD

Give All Information Completely  
Make Required Affidavit  
Mail or Deliver Report to:  
Conservation Division  
State Corporation Commission  
211 No. Broadway  
Wichita, Kansas

NORTH

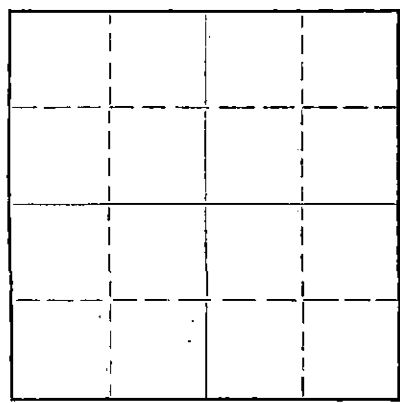

Locate well correctly on above  
Section Plat

Reno County. Sec. 1 Twp. 22 Rge. 10 (E) W (W)  
Location as "NE/CNW/SW" or footage from lines SE SE NE  
Lease Owner Lee Phillips Oil Company  
Lease Name Stout Well No. 1  
Office Address 1407 Union National Building, Wichita, Kansas  
Character of Well (completed as Oil, Gas or Dry Hole) Dry Hole  
Date well completed March 11 19 60  
Application for plugging filed " 11 19 60  
Application for plugging approved " 11 (verbally) 19 60  
Plugging commenced " 11 19 60  
Plugging completed " 11 19 60  
Reason for abandonment of well or producing formation Dry Hole

If a producing well is abandoned, date of last production \_\_\_\_\_ 19 \_\_\_\_  
Was permission obtained from the Conservation Division or its agents before plugging was commenced? Yes

Name of Conservation Agent who supervised plugging of this well Gilbert P. Toman  
Producing formation \_\_\_\_\_ Depth to top \_\_\_\_\_ Bottom \_\_\_\_\_ Total Depth of Well 3650 Feet  
Show depth and thickness of all water, oil and gas formations.

OIL, GAS OR WATER RECORDS

CASING RECORD

FORMATION	CONTENT	FROM	TO	SIZE	PUT IN	PULLED OUT
Surface			214'	8 5/8	214'	none

Describe in detail the manner in which the well was plugged, indicating where the mud fluid was placed and the method or methods used in introducing it into the hole. If cement or other plugs were used, state the character of same and depth placed, from \_\_\_\_\_ feet to \_\_\_\_\_ feet for each plug set.

Filled hole with heavy mud from total depth to 200' with a plug and 20 sacks of cement at that point. Mud to 40' with a plug and 10 sacks of cement at that point.

3-21-60  
**RECEIVED**  
STATE CORPORATION COMMISSION  
MAR 21 1960  
CONSERVATION DIVISION  
Wichita, Kansas

(If additional description is necessary, use BACK of this sheet)

Name of Plugging Contractor Harms-Burt Drilling Company  
Address P. O. Box 184, Great Bend, Kansas

STATE OF \_\_\_\_\_, COUNTY OF \_\_\_\_\_, ss.  
\_\_\_\_\_  
(employee of owner) or (owner or operator) of the above-described well, being first duly sworn on oath, says: That I have knowledge of the facts, statements, and matters herein contained and the log of the above-described well as filed and that the same are true and correct. So help me God.

(Signature) [Signature]  
P. O. Box 184, Great Bend, Kansas  
(Address)

SUBSCRIBED AND SWORN TO before me this 17th day of March, 19 60

My commission expires January 20, 1962  
Mary E. Van Pelt Notary Public.



DRILLERS LOG

Company: Lee Phillips Oil Company  
Farm: Stout #1  
Commenced: February 29, 1960  
Elevation: 1754 KB

SE SE NE Section 1-22-10W  
Reno County, Kansas  
Completed: March 11, 1960

- 0 - 140 sand
- 140 - 370 red bed
- 370 - 395 anhydrite
- 395 - 1410 shale & shells
- 1410 - 2764 lime & shale
- 2764 - 2965 lime
- 2965 - 3072 shale
- 3072 - 3402 lime
- 3402 - 3445 lime-shle-chert
- 3445 - 3485 lime & shale
- 3485 - 3511 lime & chert
- 3511 - 3535 shale-lime-chert
- 3535 - 3547 lime-shale & chert
- 3547 - 3580 cored
- 3580 - 3604 shale
- 3604 - 3650 Arbuckle
- 3650 total depth

Set 214' of 8 5/8" surface pipe, cemented with 200 sacks of common cement with 2% Calcium Chloride.

- Tops: Anhydrite - 370
- Heebner - 2931
- Brown Lime - 3072
- Lansing - 3101
- Viola - 3455
- Simpson Shale - 3538
- Arbuckle - 3604

Ran electric log.

Dry, plugged and abandoned.

3-21-60

**RECEIVED**  
STATE CORRELATION COMMISSION  
MAR 21 1960  
CONSERVATION DIVISION  
Wichita, Kansas

AFFIDAVIT

STATE OF KANSAS )  
                          ) SS  
County of Barton)

I, Allan Harms of the Harms-Burt Drilling Company being first duly sworn on oath state:  
I have knowledge of the facts, statements and matters herein contained and the same are true and correct.

Subscribed and sworn to before me this 17th day of March, 1960

Allan Harms  
\_\_\_\_\_  
Mary E. Van Belt  
\_\_\_\_\_  
Notary Public

My commission expires January 20, 1962.