


STATE OF KANSAS
STATE CORPORATION COMMISSION

Form CP-4

Give All Information Completely
Make Required Affidavit
Mail or Deliver Report to:
Conservation Division
State Corporation Commission
212 No. Market
Wichita, Kansas

WELL PLUGGING RECORD

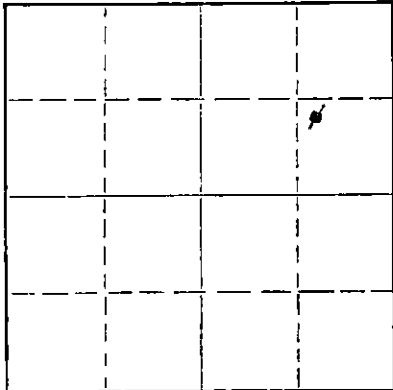

NORTH

Locate well correctly on above
Section Plat

Stafford County. Sec. 3 Twp. 24 Rge. 13W (~~S~~) (W)

Location as "NE/CNW/SW" or footage from lines NW SE NE

Lease Owner National Associated Petroleum Company

Lease Name W. D. Davis Well No. 1

Office Address 502 Ritz Building Tulsa, Oklahoma

Character of Well (completed as Oil, Gas or Dry Hole) D&A

Date well completed _____ 19__

Application for plugging filed _____ 19__

Application for plugging approved _____ 19__

Plugging commenced April 23, 19 58

Plugging completed April 23, 19 58

Reason for abandonment of well or producing formation _____

If a producing well is abandoned, date of last production _____ 19__

Was permission obtained from the Conservation Division or its agents before plugging was commenced? yes

Name of Conservation Agent who supervised plugging of this well Frank Broadfoot

Producing formation _____ Depth to top _____ Bottom _____ Total Depth of Well 3994' Feet

Show depth and thickness of all water, oil and gas formations.

OIL, GAS OR WATER RECORDS

CASING RECORD

FORMATION	CONTENT	FROM	TO	SIZE	PUT IN	PULLED OUT

RECEIVED
AUG 22 1966
COMMISSION

Describe in detail the manner in which the well was plugged, indicating where the mud fluid was placed and the method or methods used in introducing it into the hole. If cement or other plugs were used, state the character of same and depth placed, from _____ feet to _____ feet for each plug set.

8 5/8" Surface Pipe 300' CWC
Gunned pits- Filled hole with mud to 240'
Set plug- with 1/2 sack hulls - 20 sacks cement
through drill pipe- Mud to 35' - set plug with
1/3 sack hulls - 10 sacks cement- cap to base of
cellar.

(If additional description is necessary, use BACK of this sheet)

Name of Plugging Contractor National Associated Petroleum Company

Address 502 Ritz Building Tulsa, Oklahoma

STATE OF OKLAHOMA, COUNTY OF TULSA, ss.

James A. Hayes, Jr. (employee of owner) or (owner or operator) of the above-described well, being first duly sworn on oath, says: That I have knowledge of the facts, statements, and matters herein contained and the log of the above-described well as filed and that the same are true and correct. So help me God.

(Signature) J. A. Hayes, Jr. (Chief geologist)
500 Ritz Bldg. Tulsa, Okla.
(Address)

SUBSCRIBED AND SWORN TO before me this 19th day of August, 19 66

Maxine D. Provine
Notary Public.

My commission expires February 21, 1969

NATIONAL ASSOCIATED PETROLEUM COMPANY
FIFTH FLOOR, RITZ BUILDING

NW-SE-NE, Section 3, T-24S, R-13W
Stafford County, Kansas
W. D. Davis No. 1

<u>From</u>	<u>To</u>	<u>Formation</u>	<u>Remarks</u>
0	190	Surface Sand & Shale	
190	265	Sand	
265	300	Red Bed & Shale	Ran 7 jts. 8 5/8" Casing, set at 300' with 300 sacks cement
300	760	Shale & Red Bed	
760	780	Anhydrite	
780	1625	Shale & Shells	
1625	1690	Shale w/Line Streaks	
1690	1890	Line & Shale	
1890	2000	Lime	
2000	2435	Line & Shale	
2435	2565	Shale & Shells	
2565	2880	Lime & Shale	
2880	2980	Shale & Shells	
2980	3115	Lime & Shale	
3115	3830	Lime	
3830	3900	Viola Lime	
3900	3940	Lime	
3940	3945	Simpson	
3945	3959	Sand	
3959	3977	Simpson	
3977	3994	Arbuckle	T. D. Dry Hole

RECEIVED
STATE CORPORATION COMMISSION

NOV 9 1962

CONSERVATION DIVISION
Wichita, Kansas

I certify the above to be a true and exact copy of the Driller's
Log as shown by the Daily Drilling Reports.

BADGER DRILLERS, INC.

Subscribed and sworn to before me
this 8th day of May, 1958.

Notary Public Martha Maher
My Commission expires 6-26-60