


STATE OF KANSAS
STATE CORPORATION COMMISSION

Form CP-4

Give All Information Completely
Make Required Affidavit
Mail or Deliver Report to:
Conservation Division
State Corporation Commission
212 No. Market
Wichita, Kansas

WELL PLUGGING RECORD

NORTH

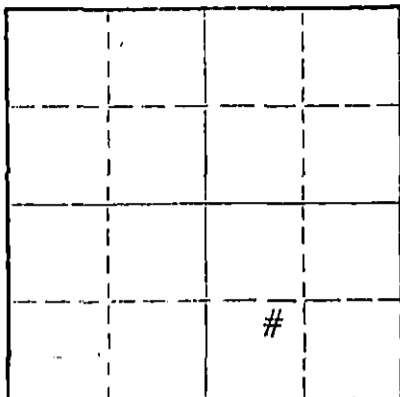

Locate well correctly on above
Section Plot

Stafford County, Sec. 2 Twp. 24 Rge. 13 (E) W (W)
Location as "NE/CNWxSWx" or footage from lines NE-SW-SE
Lease Owner Alkay Oil Company

Lease Name Kendall Well No. 1

Office Address 1606 1st Nat'l Bldg., Tulsa, Oklahoma 74103

Character of Well (completed as Oil, Gas or Dry Hole) _____

Date well completed _____ 19__

Application for plugging filed Nov. 2, 1967

Application for plugging approved Nov. 9, 1967

Plugging commenced Nov. 3, 1967

Plugging completed Nov. 17, 1967

Reason for abandonment of well or producing formation _____

If a producing well is abandoned, date of last production _____ 19__

Was permission obtained from the Conservation Division or its agents before plugging was commenced? Yes

Name of Conservation Agent who supervised plugging of this well Archie Elving

Producing formation _____ Depth to top _____ Bottom _____ Total Depth of Well 4046' Feet

Show depth and thickness of all water, oil and gas formations.

OIL, GAS OR WATER RECORDS

CASING RECORD

FORMATION	CONTENT	FROM	TO	SIZE	PUT IN	PULLED OUT
				8 5/8	250'	None
				4 1/2	3862'	2274'

Describe in detail the manner in which the well was plugged, indicating where the mud fluid was placed and the method or methods used in introducing it into the hole. If cement or other plugs were used, state the character of same and depth placed, from _____ feet to _____ feet for each plug set.

Plugged back with sand from 3610' to 3525'. Mixed and dumped 4 sx. of cement from 3525' to 3480'. Pulled casing. Mudded hole to 200'. Set 10' rock bridge from 200' to 190'. Mixed and dumped 25 sx. of cement from 190' to 115'. Mudded hole from 115' to 40'. Set 10' rock bridge from 40' to 30'. Mixed and dumped 10 sx. of cement from 30' to base of the cellar.

NOV 27 1967
11-27-67
STATE CORPORATION COMMISSION
WICHITA, KANSAS

(If additional description is necessary, use BACK of this sheet)

Name of Plugging Contractor Russ Casing Pulling Inc.

Address Box 1082' Great Bend, Ks. 67530

STATE OF Oklahoma, COUNTY OF Tulsa, ss.

A. H. Kasishke, Jr. (employee of owner) or (owner or operator) of the above-described well, being first duly sworn on oath, says: That I have knowledge of the facts, statements, and matters herein contained and the log of the above-described well as filed and that the same are true and correct. So help me God.

(Signature) A. H. Kasishke, Jr.

1606 First National Building
Tulsa, Oklahoma (Address) 74103

SUBSCRIBED AND SWORN to before me this 24th day of November, 19 67

Josephine Rawley
Notary Public.

My commission expires May 3, 1968

COPY


KANSAS GEOLOGICAL SOCIETY
KANSAS WELL LOG BUREAU--KANSAS WELL SAMPLE BUREAU
KANSAS GEOLOGICAL SOCIETY BUILDING
508 EAST MURDOCK - WICHITA, KANSAS

COMPANY ALKAY OIL
FARM Kendall NO. 1

SEC. 2 T. 24 R. 13W
LOC. NE SW SE

COUNTY Stafford

TOTAL DEPTH 4046
COMM. 12-13-66 COMP. 11-30-67
SHOT OR TREATED
CONTRACTOR Vaughan Drilling
ISSUED 1-6-67

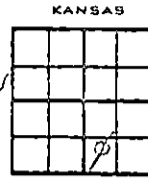

CASING
20 10
15 8 5/8" 326' cem w/ 275 sx
12 6
13 5
4 1/2" 3862'

ELEVATION 1901' KB

PRODUCTION DRY/ARB

FIGURES INDICATE BOTTOM OF FORMATIONS

COMPLETE DRILLERS LOG NOT AVAILABLE

TOPS: LOG
Anhydrite (s) 752
Topeka 3026
Heebner 3346
Brown lime 3486
Lansing 3512
Conglomerate 3806
Viola 3827
Spergen shale (s) 3954
Arbuckle (s) 4020
TD 4046

sand 165
redbed 752
Anhydrite 773
shale & shells 1455
limestone & shale 2945
limestone 3245
limestone & shale 3325
limestone 3385
shale 3486
limestone & shale 3548
limestone 3755
limestone & shale 3862
limestone & shale ? 3954
limestone & shale ? 4046
Total Depth