


STATE OF KANSAS  
STATE CORPORATION COMMISSION

Form CP-4

All Information Completely  
Required Affidavit  
or Deliver Report to:  
Conservation Division  
State Corporation Commission  
211 No. Broadway  
Wichita, Kansas

WELL PLUGGING RECORD

NORTH

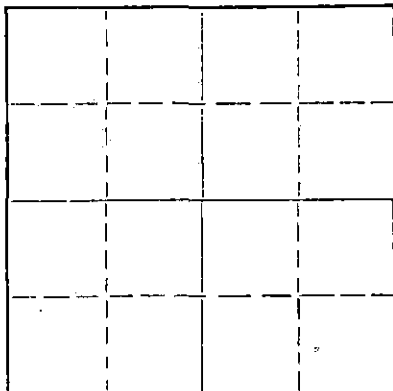

Locate well correctly on above.  
Section Plat

Edwards County. Sec. 1 Twp. 24S Rge. 16 (W)  
Location as "NE/CNW/SW" or footage from lines. SW SW NW  
Lease Owner Wilco Oil, Inc.  
Lease Name Reaves Well No. 1  
Office Address Box 13528, Phoenix, Arizona  
Character of Well (completed as Oil, Gas or Dry Hole) Gas  
Date well completed August 24 19 48  
Application for plugging filed September 4 19 63  
Application for plugging approved 19  
Plugging commenced September 13 19 63  
Plugging completed September 18 19 63  
Reason for abandonment of well or producing formation Uneconomic gas well

If a producing well is abandoned, date of last production July 19 49  
Was permission obtained from the Conservation Division or its agents before plugging was commenced? Yes

Name of Conservation Agent who supervised plugging of this well Archie V. Elving  
Producing formation Lansing-Kansas City Depth to top 3605 Bottom 3897 Total Depth of Well 4000 Feet  
Show depth and thickness of all water, oil and gas formations.

OIL, GAS OR WATER RECORDS

CASING RECORD

FORMATION	CONTENT	FROM	TO	SIZE	PUT IN	PULLED OUT
Lansing-Kansas City	Gas-wtr.	3605	3897	10 3/4 6 5/8	315 397 1/2	- 2326.14

Describe in detail the manner in which the well was plugged, indicating where the mud fluid was placed and the method or methods used in introducing it into the hole. If cement or other plugs were used, state the character of same and depth placed, from \_\_\_\_\_ feet to \_\_\_\_\_ feet for each plug set.

Cement Plug @ 3590 6 sks  
Mud from 355 1/2 to 320 15' Rock Bridge 40 sks  
Cement to base of cellar

RECEIVED  
STATE CORPORATION COMMISSION

DEC 10 1963  
12-10-63

CONSERVATION DIVISION  
Wichita, Kansas

(If additional description is necessary, use BACK of this sheet)  
Name of Plugging Contractor Glenn & Smith  
Address Box 156, Ellinwood, Kansas

STATE OF KANSAS, COUNTY OF SEDGWICK, ss.  
\_\_\_\_\_, (employee of owner) or (owner or operator) of the above-described well, being first duly sworn on oath, says: That I have knowledge of the facts, statements, and matters herein contained and the log of the above-described well as filed and that the same are true and correct. So help me God.

(Signature) James R. Daniels  
James R. Daniels  
308 Schweitzer Building, Wichita, Kansas  
(Address)

SUBSCRIBED AND SWORN TO before me this 6th day of December, 1963

My commission expires November 18, 1966

Colleen Chapple  
Colleen Chapple Notary Public.

DRILLING LOG

Operator: Max Cohen (Now Wilco Oil, Inc. )  
Contrator: Brunson Drilling Company  
Commenced: 8/2/48  
Completed: 8/24/48  
Elevation: 2051 R.B.

Well: Reaves No. 1  
Location: SW SW NW Sec. 1-24S-16W  
Edwards County, Kansas  
Casing: 10 3/4" at 315'  
6 5/8" at 3976' w/200 sx.

Figures indicate bottom of formations

Formation Tops:

Sand	150'
Clay & Sand	210'
Shale & Shells	325'
Red Shale	470'
Sand	520'
Shale & Shells	965'
Anhydrite	1010'
Shale & Shells	1320'
Sandy Shale	1650'
Shale	1860'
Shale & Lime	2680'
Shale	2930'
Lime & Shale	3467'
Shale ( Heebner)	3472'
Lime	3500'
Sand & Lime	3605'
Lime	3900'
Shale & Lime	3971'
Granite Wash	4000'
Rotary Total Depth	4000'

Anhydrite	965'
Topeka (?)	3150'
Heebner	3467'
Lans. K.C.	3605'
Base K&C.	3897'
Granite Wash	3971'
Total Depth	4000'

**RECEIVED**  
STATE CORPORATION COMMISSION

SEP 5 1963

CONSERVATION DIVISION  
Wichita, Kansas

The above log is based on information provided by the drilling contractor; on the report of the geologist employed to supervise drilling operations; and upon analysis of a radioactivity log ran on subject well. To the best knowledge of the undersigned this represents a true and correct log of the formations penetrated in the drilling of the Reaves No. 1 well.

WILCO OIL, INC.

By James R. Daniels  
James R. Daniels  
Geological Engineer

State of Kansas )  
                  ) SS  
County of Sedgwick )

Subscribed and sworn to before me, a notary public, in and for the county and state on this 4th day of September, 1963.

My commission expires 11-18-66

Colleen Chapple  
Colleen Chapple Notary Public