


Give All Information Completely
Make Required Affidavit
Mail or Deliver Report to:
Conservation Division
State Corporation Commission
211 No. Broadway
Wichita, Kansas

WELL PLUGGING RECORD

Edwards County, Sec. 1 Twp. 24 S Rge. (E) 16 (W)
Location as "NE/CNW/SW" or footage from lines SW/4 SE/4

Lease Owner Barnett Oil Company
Lease Name Neidig Well No. 1
Office Address 411 First National Bank Building, Wichita, Kansas
Character of Well (completed as Oil, Gas or Dry Hole) Dry
Date well completed April 26 1964
Application for plugging filed April 26 1964
Application for plugging approved April 26 1964
Plugging commenced April 26 1964
Plugging completed April 26 1964
Reason for abandonment of well or producing formation Dry

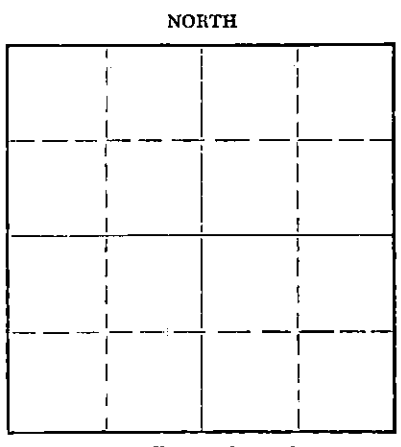

Locate well correctly on above Section Plat

If a producing well is abandoned, date of last production _____ 19____
Was permission obtained from the Conservation Division or its agents before plugging was commenced? yes

Name of Conservation Agent who supervised plugging of this well Mr. Elving
Producing formation _____ Depth to top _____ Bottom _____ Total Depth of Well 4080 Feet
Show depth and thickness of all water, oil and gas formations.

OIL, GAS OR WATER RECORDS

CASING RECORD

FORMATION	CONTENT	FROM	TO	SIZE	PUT IN	PULLED OUT
				8-5/8"	200'	none

Describe in detail the manner in which the well was plugged, indicating where the mud fluid was placed and the method or methods used in introducing it into the hole. If cement or other plugs were used, state the character of same and depth placed, from _____ feet to _____ feet for each plug set.

Fill hole with mud to 195 ft., Set plug at 195 ft. with 25 sx. cement and 1/4 sk. hulls. Fill with mud to 40 ft. and set plug at 40 ft. with 12 sx. cement and 1/4 sk. hulls. to bottom of cellar. Bridge rat hole 10 ft. from surface and dump 2 sx. cement.

RECEIVED
STATE CORPORATION COMMISSION
MAY 5 1964
5-5-64
CONSERVATION DIVISION
Wichita, Kansas

(If additional description is necessary, use BACK of this sheet)
Name of Plugging Contractor Messman-Rinehart Oil Company
Address 1432 Wichita Plaza Bldg., Wichita, Kansas

STATE OF Kansas, COUNTY OF Sedgwick, ss.
J. A. Gilliland (employee of owner) or ~~(owner or operator)~~ of the above-described well, being first duly sworn on oath, says: That I have knowledge of the facts, statements, and matters herein contained and the log of the above-described well as filed and that the same are true and correct. So help me God.

(Signature) J. A. Gilliland
1432 Wichita Plaza Bldg., Wichita, Kansas
(Address)

SUBSCRIBED AND SWORN TO before me this 30th day of April 1964
Barbara J. Scott
Barbara J. Scott, Notary Public.

My commission expires December 1, 1964



NO. 1 NEIDIG

Well Record:

Location: SW/4 SE/4, Sec. 1-24S-16W
Edwards County, Kansas
Commenced: April 12, 1964
Completed: April 26, 1964
Contractor: Messman-Rinehart Oil Company
1432 Wichita Plaza Bldg.
Wichita, Kansas
Elevation: 2056' K/B
Production: D & A
Operator: Barnett Oil Company
411 First National Bank Bldg.
Wichita, Kansas

Casing Record: 8-5/8" @ 200' w/150 sx. cement, 2 gel, 2 c.c.

* * * L O G * * *

(Figures indicate bottom of formation)

Soil and Clay	45
Sand	115
Shale & Shells	201
Shale	305
Red Bed	480
Sand	600
Shale & Shells	985
Anhydrite	1005
Shale & Shells	1875
Lime & Shale	2000
Lime	2275
Lime & Shale	2775
Shale	2960
Shale & Lime Streaks	3047
Lime	3057
Shale	3135
Lime & Shale	3305
Lime - Shale & Chalk	3370
Lime & Shale	3430
Lime	3530
Lime & Shale	3640
Lime	3718
Lime & Shale	3800
Lime	3930
Lime & Shale	4020
Lime (Cherty)	4055
Arbuckle	4080 R.T.D.

RECEIVED
STATE CORPORATION COMMISSION

MAY 5 1964

CONSERVATION DIVISION
Wichita, Kansas

The undersigned, MESSMAN-RINEHART OIL COMPANY, hereby certifies that the above log is a true and correct log of the formation encountered in drilling the above well as reflected by the Daily Drilling Reports.

MESSMAN-RINEHART OIL COMPANY

By: J. A. Gilliland
J. A. Gilliland

Subscribed and sworn to before me
this 30th day of April, 1964

By: Barbara J. Scott
Barbara J. Scott, Notary Public

My Commission Expires: December 1, 1964