


STATE OF KANSAS
STATE CORPORATION COMMISSION

WELL PLUGGING RECORD

Give All Information Completely
Make Required Affidavit
Mail or Deliver Report to:
Conservation Division
State Corporation Commission
800 Bittig Building
Wichita, Kansas

Edwards County. Sec. 1 Twp. 24 Rge. (E) 16 (W)
Location as "NE/CNW/SW" or footage from lines SW SE SE/4
Lease Owner M. B. Armer
Lease Name Neidig Well No. 1
Office Address 710 Petroleum Bldg., Wichita, Kansas
Character of Well (completed as Oil, Gas or Dry Hole) Gas
Date well completed April 19 52
Application for plugging filed May 18, 19 54
Application for plugging approved May 18, 19 54
Plugging commenced May 19, 19 54
Plugging completed May 21, 19 54
Reason for abandonment of well or producing formation Well depleted

NORTH

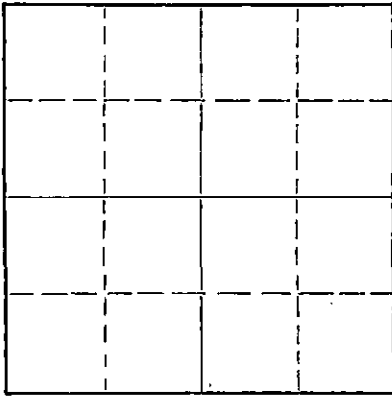

Locate well correctly on above Section Plat

If a producing well is abandoned, date of last production January 19 54
Was permission obtained from the Conservation Division or its agents before plugging was commenced? Yes

Name of Conservation Agent who supervised plugging of this well M. A. Rives
Producing formation _____ Depth to top _____ Bottom _____ Total Depth of Well 4043 Feet
Show depth and thickness of all water, oil and gas formations.

OIL, GAS OR WATER RECORDS

CASING RECORD

FORMATION	CONTENT	FROM	TO	SIZE	PUT IN	PULLED OUT
				8 5/8"	303'	None
				5 1/2"	4032'	3215'

Describe in detail the manner in which the well was plugged, indicating where the mud fluid was placed and the method or methods used in introducing it into the hole. If cement or other plugs were used, state the character of same and depth placed, from _____ feet to _____ feet for each plug set.

Set Lane-Wells plug at 3632 ft. dumped 3 sax cement
on top of Lane-Wells plug, top of cement 3610'.

Filled hole with mud to 300 ft. set rock bridge, dumped
20 sax cement - top of cement, 240 ft. Filled with mud
to 35 ft. set rock bridge, dumped 10 sax cement for cap.

(If additional description is necessary, use BACK of this sheet)

Name of Plugging Contractor Miller Casing Pulling Company
Address Great Bend, Kansas

STATE OF Kansas, COUNTY OF Sedgwick, ss.
L. C. Sponenberg (employee of owner) or (owner/operator) of the above-described well, being first duly sworn on oath, says: That I have knowledge of the facts, statements, and matters herein contained and the log of the above-described well as filed and that the same are true and correct. So help me God.

(Signature) L. C. Sponenberg
(Address) _____

SUBSCRIBED AND SWORN to before me this 3rd day of June, 19 54

My commission expires February 13, 1956.

Rose Lacey Notary Public.
RECEIVED
STATE CORPORATION COMMISSION
6-4-54
JUN 4 - 1954
CONSERVATION DIVISION
Wichita, Kansas

PLUGGING
FILE SEC 1 T 24 R 16W
BOOK PAGE 35 LINE 8

PLUGGING
 WELL SEC-T 124 N 16 W
 BOOK PAGE 32 LINE 2

RECEIVED
 STATE CORPORATION COMMISSION
 MAY 13 1954
 CONSERVATION DIVISION
 WICHITA, KANSAS









