


STATE OF KANSAS
STATE CORPORATION COMMISSION

Give All Information Completely
Make Required Affidavit
Mail or Deliver Report to:
Conservation Division
State Corporation Commission
800 Biting Building
Wichita, Kansas

WELL PLUGGING RECORD

NORTH

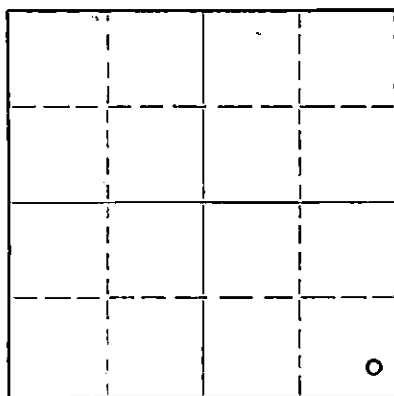

Locate well correctly on above
Section Plat

Stafford County, Sec. 8 Twp. 24 Rge. (E) 13 (W)
Location as "NE/CNWSW" or footage from lines SE SE SE
Lease Owner Westgate-Greenland Oil Company
Lease Name Garner Well No. 1
Office Address 1009 Central Building, Wichita 2, Kansas
Character of Well (completed as Oil, Gas or Dry Hole) dry hole
Date well completed May 12, 1953 19
Application for plugging filed May 12, 1953 19
Application for plugging approved May 12, 1953 19
Plugging commenced May 12, 1953 19
Plugging completed May 12, 1953 19
Reason for abandonment of well or producing formation

If a producing well is abandoned, date of last production 19
Was permission obtained from the Conservation Division or its agents before plugging was commenced? yes

Name of Conservation Agent who supervised plugging of this well M. A. Ricks
Producing formation Depth to top Bottom Total Depth of Well Feet
Show depth and thickness of all water, oil and gas formations.

OIL, GAS OR WATER RECORDS

CASING RECORD

FORMATION	CONTENT	FROM	TO	SIZE	PUT IN	PULLED OUT
surface		0	204	8 5/8"	204	none

Describe in detail the manner in which the well was plugged, indicating where the mud fluid was placed and the method or methods used in introducing it into the hole. If cement or other plugs were used, state the character of same and depth placed, from feet to feet for each plug set.

Filled hole with heavy mud from 4153 to 200 feet
Set plug at 200 feet and ran 20 sacks cement to 160 feet
Filled with heavy mud from 160 feet to 40 feet
Set plug at 40 feet and capped with 10 sacks cement.

Recd

5-14-53

(If additional description is necessary, use BACK of this sheet)

Name of Plugging Contractor Westgate Drilling Corporation
Address 1009 Central Building, Wichita 2, Kansas

STATE OF Kansas, COUNTY OF Sedgwick, ss.
G. E. Bitler (employee of owner) of the above-described

well, being first duly sworn on oath, says: That I have knowledge of the facts, statements, and matters herein contained and the log of the above-described well as filed and that the same are true and correct. So help me God.

(Signature)

1009 Central Building, Wichita 2, Kansas
(Address)

SUBSCRIBED AND SWORN TO before me this 14th day of May 1953

My commission expires May 25, 1953.

Notary Public.

24-2675-S 2-52-20M

PLUGGING
FILE SEC 8 T 24 R 13 W
BOOK PAGE 100 LINE 36

100-100000








DRILLER'S LOG

COMPANY: Westgate-Greenland Oil Company
 CONTRACTOR: Westgate Drilling Corporation
 FARM: Garner #1 SE SE SE 8-24-13W
 Stafford County, Kansas
 COMMENCED: April 28, 1953
 COMPLETED: May 11, 1953 (Plugged May 12, 1953 3AM)
 ELEVATION: 1925 DF

0	to	138	Sand
138	to	160	Sand and shale
160	to	204	Shale
204	to	800	Shale and bed bed
800	to	825	Anhydrite
825	to	1750	Shale and shells
1750	to	1830	Lime W/shale
1830	to	1966	Lime
1966	to	3570	Lime and shale
3570	to	3845	Lime
3845	to	3963	Shale and lime
3963	to	4043	Lime and chert
4043	to	4115	Shale
4115	to	4155	Arbuckle
		4155	T. D. (RB)

Set 204' of 8 5/8" surface. Cemented with 200 sacks
 pos mix and 2 sacks calcium chloride.

TOPS:	Anhydrite	815	Lansing	3568	Simpson Sh	4047
	Heebner	3400	Base KC	3827	Simpson Sd	4075
	Brown Lime	3542	Viola	3923	Arbuckle	4113

DRILL STEM TEST: 4076-87, open 1 hour, weak blow 8 minutes,
 rec. 15' very slightly oil specked mud,
 0# BHP.

Ran Schlumberger
 DRY, PLUGGED and ABANDONED

C E R T I F I C A T E

I, Harold A. Burt, do hereby certify that the above and
 foregoing is a true and correct copy of the log of the
 Garner #1 SE SE SE Section 8-24S-13W, Stafford County,
 Kansas as reflected by files of the Westgate-Greenland
 Oil Company.

Harold A. Burt
 Harold A. Burt

Subscribed and sworn to before me, a Notary Public,
 within and for Sedgwick County, Kansas, this 13th day
 of May, 1953.

Esther Unsell
 Esther Unsell, Notary Public

My commission expires May 25, 1953.

