


STATE OF KANSAS
STATE CORPORATION COMMISSION

Give All Information Completely
Make Required Affidavit
Mail or Deliver Report to:
Conservation Division
State Corporation Commission
212 North Market, Insurance Bldg.
Wichita, Kansas

WELL PLUGGING RECORD

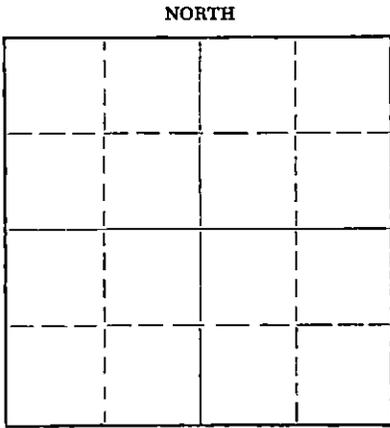

Locate well correctly on above
Section Plat

Stafford County. Sec. 7 Twp. 24 Rge. (E) 13 (W)
Location as "NE/CNW/SW" or footage from lines SE SE NW
Lease Owner Natural Gas and Oil Company
Lease Name Rixon "B" Well No. 1
Office Address P. O. Box 105, Great Bend, Kansas
Character of Well (completed as Oil, Gas or Dry Hole) Oil
Date well completed June 5, 1956 19
Application for plugging filed August 13, 1959 19
Application for plugging approved August 17, 1959 19
Plugging commenced September 1, 1959 19
Plugging completed September 11, 1959 19
Reason for abandonment of well or producing formation Depleted

If a producing well is abandoned, date of last production July 31, 1959 19
Was permission obtained from the Conservation Division or its agents before plugging was commenced? Yes

Name of Conservation Agent who supervised plugging of this well W. L. Lackamp, Jr.
Producing formation Lans. K. C. Depth to top 3759 Bottom 3811 Total Depth of Well 3905 Feet
Show depth and thickness of all water, oil and gas formations. PBTD 381 1/4 feet

OIL, GAS OR WATER RECORDS

CASING RECORD

FORMATION	CONTENT	FROM	TO	SIZE	PUT IN	PULLED OUT
				8 5/8	210	None
				5 1/2	381 1/4	2890

Describe in detail the manner in which the well was plugged, indicating where the mud fluid was placed and the method or methods used in introducing it into the hole. If cement or other plugs were used, state the character of same and depth placed, from _____ feet to _____ feet for each plug set.

Plugged to 3700 feet with sand and dumped 5 sacks cement
Pulled pipe
Squeezed with 20 sacks mud and 75 sacks cement
Set rock bridge at 110 feet
Dumped 10 sacks cement

RECEIVED
STATE CORPORATION COMMISSION
9-21-59
SEP 21 1959

CONSERVATION DIVISION
Wichita, Kansas

(If additional description is necessary, use BACK of this sheet)

Name of Plugging Contractor E & L Casing Pulling Company
Address P. O. Box 656, Great Bend, Kansas

STATE OF KANSAS COUNTY OF BARTON, ss.
J. B. Steele, Jr. (employee of owner) ~~Not a conservation agent~~ of the above-described well, being first duly sworn on oath, says: That I have knowledge of the facts, statements, and matters herein contained and the log of the above-described well as filed and that the same are true and correct. So help me God.

(Signature) J. B. Steele, Jr.
P. O. Box 105, Great Bend, Kansas
(Address)

SUBSCRIBED AND SWORN TO before me this 17 th day of September, 1959

Richard R. Brack
Notary Public.

My commission expires July 27, 1963

PLUGGING
FILE SEC. 7 T. 24 R. 13W
BOOK PAGE 60 LINE 12

NO. 1 RIXON "B"

WELL LOG

Location: SE SE NW, 7-24S-13W
Stafford County, Kansas

Commenced: May 16, 1956

Operator: Natural Gas and Oil Corporation
Route 1, Great Bend, Kansas

Completed: May 26, 1956

Contractor: Messman-Rinehart Drilling Company
5th Floor, Petroleum Bldg., Wichita, Kans.

Elevation: 1929 KB (1924 Gr)

Casing Record: 8 5/8" @ 238' w/175 sacks cement
5 1/2" @ 384 1/4' w/50 sacks cement

Production:

.....L O G.....

Sand	70
Shale-Sand	150
Shale	210
Red Bed-Shale	540
Shale	822
Anhydrite	845
Shale	1645
Lime-Shale	2115
Shale-Lime	2258
Shale	2416
Shale-Lime	2605
Shale	2784
Shale-Lime	3065
Shale	3170
Lime-Shale	3390
Shale-Lime	3580
Lime-Shale	3640
Lime	3905 R.T.D.

Sample Tops:

Heebner 3419 (-1490)
Brown Lime 3552 (-1623)
Lans/K.C. 3579 (-1650)
Mississippi 3895 (-1966)

The undersigned, MESSMAN-RINEHART DRILLING COMPANY, hereby certifies that the above log is a true and correct log of the formation encountered in drilling the above well as reflected by the Daily Drilling Report.

MESSMAN-RINEHART DRILLING COMPANY

BY: J. A. Gilliland
J. A. Gilliland

Subscribed and sworn to before me
this 5th day of June 1956.

Juanita L. Lewis
Notary Public

My Commission Expires: November 5, 1958

RECEIVED
STATE CORPORATION COMMISSION
AUG 14 1959
DIVISION

PLUGGING
FILE SEC 7 T 24 R 13W
BOOK PAGE 60 LINE 12