


STATE OF KANSAS
STATE CORPORATION COMMISSION

WELL PLUGGING RECORD

Give All Information Completely
Make Required Affidavit
Mail or Deliver Report to
Conservation Division
State Corporation Comm.
245 North Water
Wichita, KS 67202

Stafford County, Sec. 7 Twp. 24S Rge. 13W E/W
Location as "NE/CNW $\frac{1}{4}$ SW $\frac{1}{4}$ " or footage from lines
150' E C NE SW SW
Lease Owner Petroleum, Inc.
Lease Name Rixon "A" Well No. 3
Office Address R. H. Garvey Bldg, Wichita, Kansas
Character of Well (Completed as Oil, Gas or Dry Hole)
Dry Hole

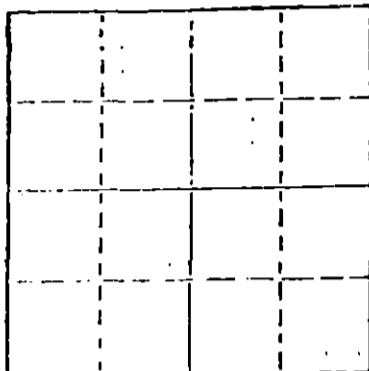

Locate well correctly on above
Section Plot

Date Well completed February 8 19 81
Application for plugging filed February 8 19 81
Application for plugging approved February 8 19 81
Plugging commenced February 8 19 81
Plugging completed February 8 19 81
Reason for abandonment of well or producing formation
Dry Hole

If a producing well is abandoned, date of last production
19

Was permission obtained from the Conservation Division or
its agents before plugging was commenced? Yes

Name of Conservation Agent who supervised plugging of this well Toman
Producing formation Depth to top Bottom Total Depth of Well 4186
Show depth and thickness of all water, oil and gas formations.

OIL, GAS OR WATER RECORDS

CASING RECORD

FORMATION	CONTENT	FROM	TO	SIZE	PUT IN	PULLED OUT
				8 5/8	289	-0-

Describe in detail the manner in which the well was plugged, indicating where the mud fluid
was placed and the method or methods used in introducing it into the hold. If cement or other
plugs were used, state the character of same and depth placed, from feet to
feet for each plug set.

Plugged with 50 sx @ 700',
25 sx cement @ 290', Bridge
and 10 sx @ 40', 5 sx in
rathole.

(If additional description is necessary, use BACK of this sheet)

Name of Plugging Contractor B & B Drilling, Inc.

STATE OF Kansas COUNTY OF Sedgwick, ss.
Bill Lahar (employee of owner) or (owner or operator)
of the above-described well, being first duly sworn on oath, says: That I have knowledge of
the facts, statements, and matters herein contained and the log of the above-described well
as filed and that the same are true and correct. So help me God.

(Signature) *Bill Lahar*

515 Union Center, Wichita, Kansas
(Address)

SUBSCRIBED AND SWORN TO before me this 17 day of February, 19 81

My commission expires



Betty M. Abbott
Betty M. Abbott Notary Public.

RECEIVED
STATE CORPORATION COMMISSION
2-20-81
FEB 20 1981

CONSERVATION-DIVISION
Wichita, Kansas

DRILLERS LOG

February 17, 1981

#3 Rixon "A"
150' E C NE SW SW
Sec. 7-245-13W
Stafford Co., Kansas

OPERATOR: Petroleum, Inc.
CONTRACTOR: B & B Drilling, Inc.
COMMENCED: January 29, 1981
COMPLETED: February 8, 1981

8 5/8" @ 289' w/225 sx


0	291	Redbed & Sand	
291	822	Redbed	
822	848	Anhydrite	
848	1956	Sand & Shale	
1956	2808	Lime & Shale	
2808	3902	Lime	
3902	4006	Shale	
4006	4186	Lime	
4186		RTD	D & A

We certify that the above and foregoing is a true and correct copy of the log on the #3 Rixon "A" located in Stafford County, Kansas.

B & B DRILLING, INC.


Bill Lahar

Subscribed and sworn to before me this 17th day of February, 1981.

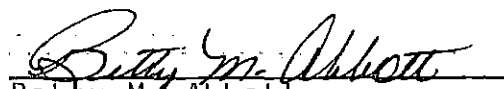
Betty M. Abbott



RECEIVED
STATE OF KANSAS COMMISSION

FEB 20 1981

CONSERVATION DIVISION
Wichita, Kansas