


STATE OF KANSAS  
STATE CORPORATION COMMISSION

Give All Information Completely  
Make Required Affidavit  
Mail or Deliver Report to:  
Conservation Division  
State Corporation Commission  
211 No. Broadway  
Wichita, Kansas

WELL PLUGGING RECORD

NORTH

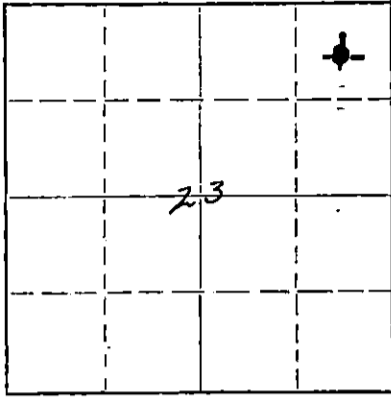

Locate well correctly on above  
Section Plat

Stafford County, Sec. 23 Twp. 24S Rge. 15W (~~EX~~) (W)  
Location as "NE/CNW%SW%" or footage from lines C NE 1/4 NE 1/4  
Lease Owner D. R. Lauck Oil Company, Inc.  
Lease Name Fry Well No. 1  
Office Address 301 S. Broadway, Wichita, Kansas  
Character of Well (completed as Oil, Gas or Dry Hole) Dry Hole  
Date well completed November 20, 1961  
Application for plugging filed November 20, 1961  
Application for plugging approved November 20, 1961  
Plugging commenced November 20, 1961  
Plugging completed November 20, 1961  
Reason for abandonment of well or producing formation Dry Hole

If a producing well is abandoned, date of last production \_\_\_\_\_ 19\_\_\_\_  
Was permission obtained from the Conservation Division or its agents before plugging was commenced? Yes

Name of Conservation Agent who supervised plugging of this well Bill LaKemp  
Producing formation \_\_\_\_\_ Depth to top \_\_\_\_\_ Bottom \_\_\_\_\_ Total Depth of Well 4416 Feet  
Show depth and thickness of all water, oil and gas formations.

OIL, GAS OR WATER RECORDS

CASING RECORD

| FORMATION | CONTENT | FROM | TO   | SIZE   | PUT IN | PULLED OUT |
|-----------|---------|------|------|--------|--------|------------|
|           |         | 0'   | 218' | 8-5/8" | 218'   | None       |
|           |         |      |      |        |        |            |
|           |         |      |      |        |        |            |
Describe in detail the manner in which the well was plugged, indicating where the mud fluid was placed and the method or methods used in introducing it into the hole. If cement or other plugs were used, state the character of same and depth placed, from \_\_\_\_\_ feet to \_\_\_\_\_ feet for each plug set.

|              |                                    |
|--------------|------------------------------------|
| 4416' - 200' | Mud                                |
| 200' - 196'  | Plug                               |
| 196' - 156'  | Cement 20 sacks                    |
| 156' - 35'   | Mud                                |
| 35' - 31'    | Plug                               |
| 31' - 6'     | Cement 10 sacks (Bottom of Cellar) |

REC'D  
11-29-61  
DIVISION

(If additional description is necessary, use BACK of this sheet)

Name of Plugging Contractor Globe Cementing Company  
Address Great Bend, Kansas

STATE OF KANSAS, COUNTY OF SEDGWICK, ss.  
John H. Knightley (employee of owner) or (owner or operator) of the above-described well, being first duly sworn on oath, says: That I have knowledge of the facts, statements, and matters herein contained and the log of the above-described well as filed and that the same are true and correct. (So help me God.)

(Signature) John H. Knightley  
301 S. Broadway, Wichita, Kansas  
(Address)

SUBSCRIBED AND SWORN to before me this 28th day of November, 19 61.

Stella J. Bodine  
Notary Public.

My commission expires March 12, 1963



D. R. Lauck Oil Company, Inc.

Fry #1

C NE NE Sec. 23-24S-15W  
Stafford County, Kansas

Commenced: November 8, 1961  
Completed: November 20, 1961

Casing Record: 218' 8-5/8" Cemented w/170 sacks cement,  
4 sacks of Calcium Chloride.

Elevation: GL 2012; DF 2015; KB 2017.

Drillers Log

Tops

|                           |          |
|---------------------------|----------|
| Sand                      | 110      |
| Shale                     | 295      |
| Red Bed                   | 455      |
| Sand                      | 490      |
| Red Bed                   | 960      |
| Anhydrite                 | 985      |
| Red Bed                   | 1250     |
| Red Bed & Shale           | 1380     |
| Red Bed & Shale & Shells  | 1650     |
| Shale & Shells            | 1800     |
| Anhydrite                 | 1890     |
| Anhydrite & Shale Streaks | 2025     |
| Lime & Shale              | 2350     |
| Shale & Lime              | 2750     |
| Shale & Shells            | 2965     |
| Shale & Lime              | 3200     |
| Lime & Shale              | 3485     |
| Lime                      | 3569     |
| Lime & Shale              | 3645     |
| Shale & Lime              | 3715     |
| Lime                      | 4048     |
| Lime & Shale              | 4105     |
| Shale & Lime              | 4145     |
| Shale, Lime & Chert       | 4183     |
| Chert, Lime & Shale       | 4220     |
| Chert & Shale             | 4246     |
| Chert                     | 4270     |
| Shale & Lime              | 4310     |
| Sand                      | 4312     |
| Simpson                   | 4359     |
| Sand                      | 4370     |
| Arbuckle Lime             | 4416 RTD |

|                  | Sample    |
|------------------|-----------|
| Heebner          | 3573-1556 |
| Toronto          | 3590-1573 |
| Douglas          | 3610-1593 |
| Brown Lime       | 3714-1697 |
| Lansing          | 3727-1710 |
| Base Kansas City | 3993-1976 |
| Mississippian    | ----      |
| Kinderhook       | 4104-2087 |
| Viola            | 4165-2148 |
| Simpson          | 4291-2274 |
| Arbuckle         | 4366-2349 |

DST #1 (M) 4307-4312, open 1 hour  
with strong blow 1 hour.  
Recovered 790' slightly gas-  
cut water with specks of oil.

ISIP 1447# 30 min.  
FSIP 1336# 30 min.  
IFP 44#  
FFP 337#

D&A

RECEIVED  
STATE CORPORATION COMMISSION  
NOV 29 1961  
REGISTRATION DIVISION