

STATE OF KANSAS  
STATE CORPORATION COMMISSION

WELL PLUGGING RECORD


Give All Information Completely  
Make Required Affidavit  
Mail or Deliver Report to:  
Conservation Division  
State Corporation Commission  
800 Bittling Building  
Wichita, Kansas

OR

FORMATION PLUGGING RECORD

Strike out upper line  
when reporting plug-  
ging of formations.

NORTH

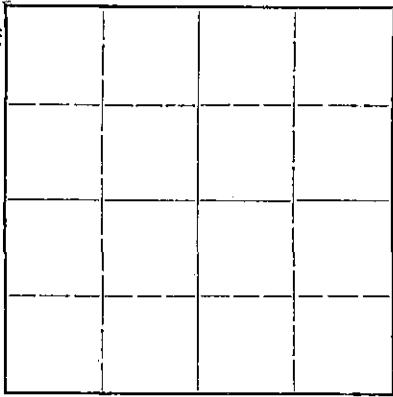

Locate well correctly on above  
Section Flat

Pratt County. Sec 27 Twp 29S Rge (E) 14 (W)  
Location as "NE 1/4 NW 1/4 SW 1/4" or footage from lines 330' Fr. E. & 990' Fr. S. SE 1/4  
Lease Owner Phillips Petroleum Co.  
Lease Name Meredith Well No 1  
Office Address Bartlesville, Okla.  
Character of Well (completed as Oil, Gas or Dry Hole) Dry hole  
Date well completed 9-19-47 19  
Application for plugging filed 9-19-47 19  
Application for plugging approved 9-19-47 19  
Plugging commenced 9-19-47 19  
Plugging completed 9-20-47 19  
Reason for abandonment of well or producing formation Dry hole  
If a producing well is abandoned, date of last production 19  
Was permission obtained from the Conservation Division or its agents before plugging was com-  
menced? yes

Name of Conservation Agent who supervised plugging of this well H.W. Kerr  
Producing formation Depth to top Bottom Total Depth of Well 4660 Feet  
Show depth and thickness of all water, oil and gas formations.

OIL, GAS OR WATER RECORDS

CASING RECORD

Formation	Content	From	To	Size	Put In	Pulled Out
Conglomerate		4463		8 5/8"	897	none
Viola		4482				
Simpson Sand		4529				
Arb.		4626				

Describe in detail the manner in which the well was plugged, indicating where the mud fluid was placed and the method or methods used in introducing it into the hold. If cement or other plugs were used, state the character of same and depth placed, from feet to feet for each plug set.

At TD. of 4660' ran 60 sacks cement - Filled with mud to 897'  
Ran 15 sacks cement - Filled with mud to 10' - Ran 10 sacks  
cement to cap.

(If additional description is necessary, use BACK of this sheet)

Correspondence regarding this well should be addressed to N.C. Mortimer  
Address Great Bend, Kans. Box 779

STATE OF Kansas COUNTY OF Barton, ss.

A.L. Rhodes (employee of owner) or (owner or operator) of the above-described well,  
being first duly sworn on oath, says: That I have knowledge of the facts, statements, and matters herein contained and the log of the above-  
described well as filed and that the same are true and correct. So help me God.

(Signature) A.L. Rhodes

Great Bend, Kans. Box 779  
(Address)

SUBSCRIBED AND SWORN to before me this 19 th. day of December, 1947

My commission expires March 27 th. 1950

12-20-47

J. Marsh  
Notary Public.

PLUGGING  
FILE NO 27 29 R 14 W  
LOG PAGE 135 INT 18

## Formation Record

Lease Meredith

Well No. 1

FROM	TO	Formation	REMARKS
0	25	Surface Clay	
25	175	Sand and gravel	
175	720	Red bed ✓	
720	1375	Shale and shells	
1375	1685	Shale and salt	
1685	1800	Shale	
1800	1870	Shale and lime	
1870	2000	Broken lime	
2000	2535	Lime	
2535	3200	Shale and lime	
3200	3770	Lime	
3770	3845	Shale and lime	
3845	3910	Sandy shale	
3910	3995	Shale and lime	
3995	4365	Lime	
4365	4422	Lime and shale	
4422	4427	Shale	
4427	4465	Lime	
4465	4490	Conglomerate	
4490	4520	Lime and chert	
4520	4535	Shale and lime	
4535	4540	Sand	
4540	4573	Sand and shale	
4573	4623	Shale	
4623	4660	Lime	

PLUINGING  
 FILE SEC 27 T 29 R 14 W  
 LOCK PAGE 135 UNIT 18

DEC 20 1947