

STATE OF KANSAS
STATE CORPORATION COMMISSION

WELL PLUGGING RECORD


OR
FORMATION PLUGGING RECORD

Strike out upper line
when reporting plug-
ging off formations.

Give All Information Completely
Make Required Affidavit
Mail or Deliver Report to:
Conservation Division
State Corporation Commission
800 Bittling Building
Wichita, Kansas

Reno County. Sec. 32 Twp. 22 Rge. (E) 9 (W)
Location as "NE 1/4 NW 1/4 SW 1/4" or footage from lines 330' S. & 330' E. of N/4 Cor.
Lease Owner. Cities Service Oil Company
Lease Name. Johnson "D"
Office Address. Bartlesville, Oklahoma
Character of Well (completed as Oil, Gas or Dry Hole). Dry Hole
Date well completed. May 15, 19.46
Application for plugging filed. May 15, 19.46
Application for plugging approved. May 15, 19.46
Plugging commenced. May 15, 19.46
Plugging completed. May 16, 19.46
Reason for abandonment of well or producing formation. Non-productive

NORTH

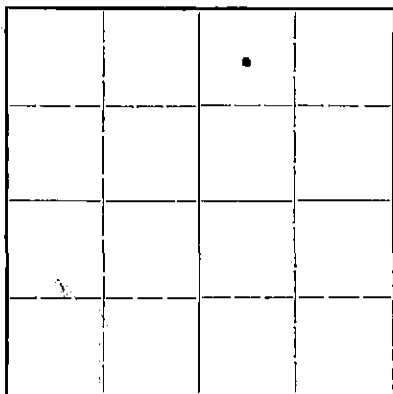

Locate well correctly on above
Section Plat

If a producing well is abandoned, date of last production. 19.
Was permission obtained from the Conservation Division or its agents before plugging was com-
menced? Yes

Name of Conservation Agent who supervised plugging of this well. H. W. Kerr
Producing formation. Viola Depth to top. 3703' Bottom. 3730' Total Depth of Well. ~~3750~~ 3750 Feet
Show depth and thickness of all water, oil and gas formations.


OIL, GAS OR WATER RECORDS

CASING RECORD

Formation	Content	From	To	Size	Put In	Pulled Out
				8-5/8"	245'	None

Describe in detail the manner in which the well was plugged, indicating where the mud fluid was placed and the method or methods used in introducing it into the hole. If cement or other plugs were used, state the character of same and depth placed, from _____ feet to _____ feet for each plug set.

Heavy mud 3750 to 240'
Wood plug and 15 sacks cement 240' to 195'
Mud and soil 195' to 35'
10 sacks cement 35' to base of cellar

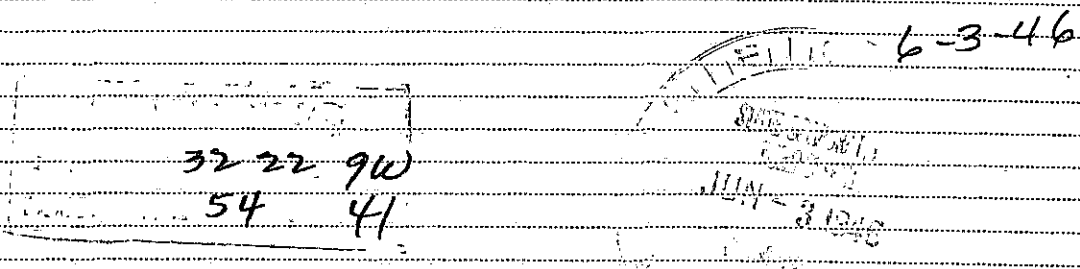

(If additional description is necessary, use BACK of this sheet)

Correspondence regarding this well should be addressed to. R. C. Hauber
Address. Box 751
Great Bend, Kansas

STATE OF Kansas, COUNTY OF Barton, ss.
V. M. Conover (employee of owner) of the above-described well,

being first duly sworn on oath, says: That I have knowledge of the facts, statements, and matters herein contained and the log of the above-described well as filed and that the same are true and correct. So help me God.

(Signature) V.M. Conover
Box 751, Great Bend, Kansas (Address)

SUBSCRIBED AND SWORN to before me this 17th day of May, 19.46
W.G. Smith
Notary Public.

My commission expires March 12, 1947.

15-155-00159-0000

Company Cities Service Oil Co. Well No. 1 Farm Johnson "D"
 Location 330' South and 330' East of N/4 Corner Sec. 32 T. 22 R. 9W
 Elevation 1728 (Gr. 1721) County Reno State Kansas
 Drig. Comm. May 1, 1946 Contractor Corbett-Barbour Drilling Company
 Drig. Comp. May 14, 1946 Acid None
 T. D. 3750' Initial Prod. Dry - Plugged and Abandoned

CASING RECORD:

8-5/8" @ 242' cen. 175 sx cen. and 2 sx C. C.

Top Lansing	3198'
Top Viola	3703'
Penetration	47'
Total Depth	3750'

FORMATION RECORD:

sand & shale	0-200
shale & shells	245
red bed	310
anhydrite	365
shale & shells	1280
shale & lime shells	1490
lime	1600
shale & lime	1730
lime	1855
lime & shale	2155
shale & lime	2830
lime	2875
lime & shale	2980
shale & lime	3135
lime & shale	3230
lime	3305
lime & shale	3370
lime	3550
lime & shale	3595
shale	3695
cored lime (no rec.)	3704
lime	3750 T. D.

Drill stem test 3705-30, recovered 60' rotary mud, no oil, no gas.

SYFO:	500'	0°
	1040'	0°
	1500'	0°
	2000'	0°
	2500'	1°
	3000'	0°
	3500'	0°

7-7/8" hole.

PLUGGED
 32 22 9W
 54 41

6-3-46
 JUN - 3 1946