

STATE OF KANSAS
STATE CORPORATION COMMISSION

Form CP-4


Give All Information Completely
Make Required Affidavit
Mail or Deliver Report to:
Conservation Division
State Corporation Commission
211 No. Broadway
Wichita, Kansas

WELL PLUGGING RECORD

Reno County, Sec. 33 Twp. 22 Rge. (E) 9 (W)

Location as "NE/CNW/SW" or footage from lines SW SW SW
Lease Owner Burch Exploration LTD.
Lease Name Shafer Well No. 1
Office Address 1011 Union Center, Wichita, Kansas
Character of Well (completed as Oil, Gas or Dry Hole) dry hole
Date well completed 10-13-64 19
Application for plugging filed 10-13-64 19
Application for plugging approved 19
Plugging commenced 10-13-64, 2:30 a.m. 19
Plugging completed: 4:30 a.m., 10-13-64 19
Reason for abandonment of well or producing formation dry hole

NORTH

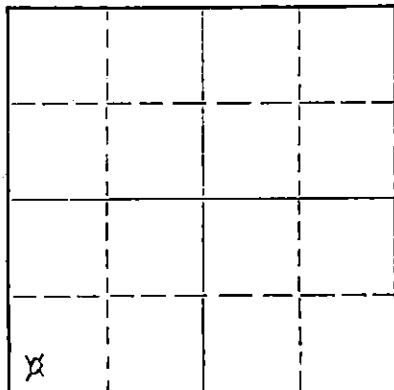

Locate well correctly on above Section Plat

If a producing well is abandoned, date of last production 19
Was permission obtained from the Conservation Division or its agents before plugging was commenced? yes

Name of Conservation Agent who supervised plugging of this well Gilbert Toman
Producing formation _____ Depth to top _____ Bottom _____ Total Depth of Well _____ Feet
Show depth and thickness of all water, oil and gas formations.

OIL, GAS OR WATER RECORDS

CASING RECORD

FORMATION	CONTENT	FROM	TO	SIZE	PUT IN	PULLED OUT
		0'	242'	8 5/8"	242'	none

Describe in detail the manner in which the well was plugged, indicating where the mud fluid was placed and the method or methods used in introducing it into the hole. If cement or other plugs were used, state the character of same and depth placed, from _____ feet to _____ feet for each plug set.

Bottom plug @ 235' with 1/4 sack hulls and 20# sx cement.,
Top plug @ 40' with 1/2 sack hulls and 10 sx cement
2 sacks cement in rat hole.

10-28-64

RECEIVED
STATE CORPORATION COMMISSION

OCT 28 1964

CONSERVATION DIVISION
Wichita, Kansas

(If additional description is necessary, use BACK of this sheet)

Name of Plugging Contractor Vaughan Drilling, Inc.
Address X Box 825, Great Bend, Kansas

STATE OF KANSAS, COUNTY OF BARTON, ss.
Donald D. Vaughan (employee of owner) or (owner or operator) of the above-described

well, being first duly sworn on oath, says: That I have knowledge of the facts, statements, and matters herein contained and the log of the above-described well as filed and that the same are true and correct. So help me God.

(Signature) Donald D. Vaughan
Box 825, Great Bend, Kansas
(Address)

SUBSCRIBED AND SWORN TO before me this 26th day of October, 1964

My commission expires M Jan. 24, 1968

Dorothy Kelly
Dorothy Kelly, Notary Public.

WELL LOG

COMPANY Burch Exploration, LTD.
 CONTRACTOR Vaughan Drilling, Inc.
 FARM #1 Shafer
 LOCATION SW SW SW of 33-22S-9W
 Reno County, Kansas
 ELEVATION 1733 K. B.
 SURFACE PIPE 242' of 8 5/8" cement with 200 sx posmis sunset.
 PRODUCTION D & A
 COMMENCED 10-3-64
 COMPLETED 10-13-64

<u>FORMATION</u>	<u>DEPTH</u>
Surface Clay & Sandstone	50
Sandstone	180
Sandstone and Shale	215
Red Bed	242
Red Bed & Shale	353
Anhydrite	366
Shale	430
Shale & Shells	1255
Limestone and Shale	2697
Limestone	3015
Limestone & Shale	3237
Limestone	3480
Limestone & Shale	3545
Limestone, Shale & Chert	3585
Limestone & Shale	3729
Limestone, Shale & Chert	3758
Limestone	3800
Limestone & Shale	3870
Sandstone & Shale	3905
Arbuckle	3937
RTD	3937

10-28-64
RECEIVED
 STATE CORPORATION COMMISSION
 OCT 28 1964
 CONSERVATION DIVISION
 Wichita, Kansas

FORMATION TOPS

Heebner	3002 (-1269)
Brn. Lime	3164 (-1431)
Lansing	3193 (-1460)
Base Kansas City	3510 (-1777)
Conglomerate	3522 (-1789)
Mississippi	3550 (-1817)
Kinderhook	3580 (-1847)
Viola	3740 (-2007)
Simpson	3828 (-2095)
Arbuckle	3900 (-2167)

A F F I D A V I T

STATE OF KANSAS, COUNTY OF BARTON, SS:

I, Donald D. Vaughan, of the VAUGHAN DRILLING, INC., being first duly sworn on oath, state that I have knowledge of the facts, statements and matters herein contained and that the same are true and correct.

Donald D. Vaughan
 Donald D. Vaughan

Subscribed and sworn to before me this 26th day of October, 1964.

My commission expires: Jan. 24, 1968.

Dorothy Tully
 Dorothy Tully, Notary Public