

STATE OF KANSAS
STATE CORPORATION COMMISSION


Give All Information Completely
Make Required Affidavit
Mail or Deliver Report to:
Conservation Division
State Corporation Commission
212 North Market, Insurance Bldg.
Wichita, Kansas

WELL PLUGGING RECORD

Stafford

County. Sec. 35 Twp. 24S Rge. 15W (E) (W)
NE NE NW

Location as "NE/CNW%SW%" or footage from lines
Lease Owner Tomlinson-Kathol, Inc.
Lease Name Blount Well No. 1
Office Address 414 Union Center, Wichita, Kansas
Character of Well (completed as Oil, Gas or Dry Hole) Dry Hole
Date well completed 3/3/1961
Application for plugging filed 3/3/1961
Application for plugging approved 3/3/1961
Plugging commenced 3/3/1961
Plugging completed 3/3/1961
Reason for abandonment of well or producing formation Dry

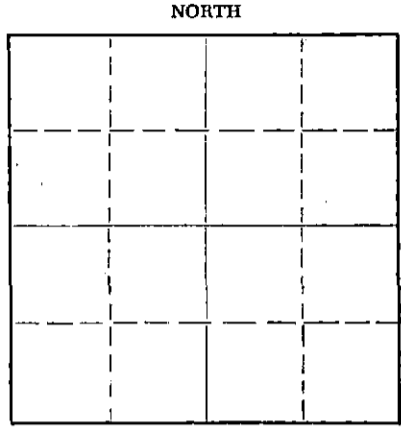

Locate well correctly on above Section Plat

If a producing well is abandoned, date of last production 19
Was permission obtained from the Conservation Division or its agents before plugging was commenced? yes

Name of Conservation Agent who supervised plugging of this well Frank Broadfoot
Producing formation None Depth to top Bottom Total Depth of Well 4500 Feet
Show depth and thickness of all water, oil and gas formations.

OIL, GAS OR WATER RECORDS

CASING RECORD

FORMATION	CONTENT	FROM	TO	SIZE	PUT IN	PULLED OUT
				8-5/8	250	

Describe in detail the manner in which the well was plugged, indicating where the mud fluid was placed and the method or methods used in introducing it into the hole. If cement or other plugs were used, state the character of same and depth placed, from feet to feet for each plug set.

Filled hole with drilling mud. Set plug at 210' w/20 sacks cement. Filled hole with mud and set top plug at 35' w/10 sacks of cement.

RECEIVED
STATE CORPORATION COMMISSION
3-9-61
CONSERVATION DIVISION
Wichita, Kansas

(If additional description is necessary, use BACK of this sheet)
Name of Plugging Contractor Tomlinson-Kathol, Inc.
Address 414 Union Center, Wichita, Kansas

STATE OF Kansas COUNTY OF Sedgwick, ss.
Warren E. Tomlinson (employee of owner) or (owner or operator) of the above-described well, being first duly sworn on oath, says: That I have knowledge of the facts, statements, and matters herein contained and the log of the above-described well as filed and that the same are true and correct. So help me God.

(Signature) Warren E. Tomlinson
414 Union Center, Wichita, Kansas
(Address)

SUBSCRIBED AND SWORN TO before me this 8th day of March, 1961

My commission expires Jan. 19, 1965
Esther Lamone
Notary Public.



DRILLERS LOG
 TOMLINSON-KATHOL, INC.
 # 1 BLOUNT
 NE NE NW, SEC. 35-24S-15W
 STAFFORD COUNTY, KANSAS

Contractor - Tomlinson-Kathol, Inc.

Commenced: 2/20/61
 Completed: 3/3/61
 Elevation: 2021 KB

<u>From</u>	<u>To</u>	<u>Description</u>	<u>Remarks</u>
0	173	Sand	
173	225	Clay	
225	248	Shale	250' 8-5/8" Surf. Csg. w/240 Sacks cement
248	470	Shale	
470	550	Dakota Sand	
550	955	Shale	
955	1010	Anhydrite	
1010	1786	Shale	
1786	1805	Sand	
1805	1965	Lime	
1965	2111	Shale	
2111	2219	Shale - Lime	
2219	3225	Shale	
3225	3622	Shale & Lime	
3622	3685	Lime & Shale	
3685	3771	Shale - Lime	
3771	4114	Lime	
4114	4173	Lime & Shale	
4173	4233	Lime	
4233	4312	Chert - Shale	
4312	4334	Chert	
4334	4403	Chert - Shale	
4403	4455	Simpson Shale	
4455	4500	Arbuckle	Heebner 3607
4500		Total Depth	Brown Lime 3754
			Lansing 3769
			Viola 4249
			Simpson 4365
			Arbuckle 4454

RECEIVED
 STATE CORPORATION COMMISSION

MAR 9 1961

CORPORATION DIVISION
 Wichita, Kansas

I certify to the best of my knowledge and belief, the above represents a true and accurate Driller's Log record of the captioned well.

Warren E. Tomlinson
 Warren E. Tomlinson

State of Kansas)
)
 County of Sedgwick)

Subscribed and sworn to before me this 8th day of March, 1961.

Esther Lamone
 Esther Lamone, Notary Public

My Commission Expires: 1/19/65