


STATE OF KANSAS
STATE CORPORATION COMMISSION
Give All Information Completely
M.A.S. Required Affidavit
Mail or Deliver Report to:
Conservation Division
State Corporation Commission
800 Bitting Building
Wichita, Kansas

WELL PLUGGING RECORD

NORTH

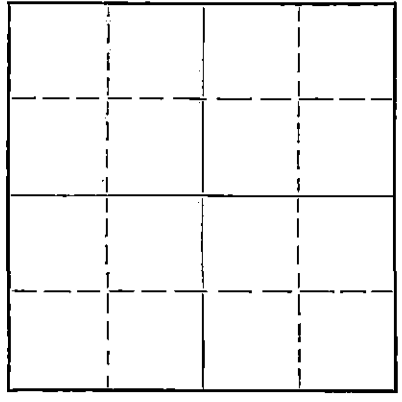

Locate well correctly on above
Section Plat

Stafford County. Sec. 35 Twp. 24 Rge. 15 (E) (W)
Location as "NE/CNW $\frac{1}{4}$ SW $\frac{1}{4}$ " or footage from lines SW SW SE
Lease Owner John Lindas Oil, Inc.
Lease Name Giles Well No. 1
Office Address 1316 Union National Bank Bldg, Wichita, Kansas
Character of Well (completed as Oil, Gas or Dry Hole) Dry
Date well completed August 2 19 52
Application for plugging filed August 3 19 52
Application for plugging approved August 3 19 52
Plugging commenced August 3 19 52
Plugging completed August 3 @ 9:00 p.m. 19 52
Reason for abandonment of well or producing formation dry

If a producing well is abandoned, date of last production 19
Was permission obtained from the Conservation Division or its agents before plugging was commenced? yes

Name of Conservation Agent who supervised plugging of this well Murial Rize
Producing formation Depth to top Bottom Total Depth of Well 4480 Feet
Show depth and thickness of all water, oil and gas formations.

OIL, GAS OR WATER RECORDS

CASING RECORD

Formation	Content	From	To	Size	Put In	Pulled Out
				8-5/8"	202'	

Describe in detail the manner in which the well was plugged, indicating where the mud fluid was placed and the method or methods used in introducing it into the hole. If cement or other plugs were used, state the character of same and depth placed, from feet to feet for each plug set.

Filled hole with mud to 200'. Set plug and 20 sacks cement. Filled hole with mud to 35' and 10 sacks cement.

(If additional description is necessary, use BACK of this sheet)

Name of Plugging Contractor John Lindas Oil, Inc.
Address 1316 Union Nat'l Bank Bldg., Wichita, Kansas

STATE OF KANSAS, COUNTY OF SEDGWICK, ss.
I, F. M. Callaway (employee of owner) of the above-described well,
being first duly sworn on oath, says: That I have knowledge of the facts, statements, and matters herein contained and the log of the above-described well as filed and that the same are true and correct. So help me God.

(Signature) *F. M. Callaway*
1316 Union National Bank Bldg; Wichita, Kansas
(Address)

SUBSCRIBED AND SWORN to before me this 14th day of August, 19 52

My commission expires October 8, 1955
Edward W. Wiers Notary Public.

PLUGGING
FILE SEC. 35 T. 24 R. 15 S. W. 4
BOOK PAGE 35 LINE 33

Rec'd
8-6-52



I

ICI

AUG 5 1952

ICI

RECEIVED
AUG 5 1952
FBI

