


STATE OF KANSAS  
STATE CORPORATION COMMISSION

WELL PLUGGING RECORD

Give All Information Completely  
Make Required Affidavit  
Major Deliver Report to:  
Conservation Division  
State Corporation Commission  
211 No. Broadway  
Wichita, Kansas

Stafford County. Sec. 35 Twp. 24 Rge. 15 (E)W. (W)  
Location as "NE/CNW/SW" or footage from lines Gen. S/2 NW SW  
Lease Owner Cities Service Oil Company  
Lease Name Barstow Well No. 3  
Office Address Box 144, Great Bend, Kansas  
Character of Well (completed as Oil, Gas or Dry Hole) Oil Well  
Date well completed October 5, 19 50  
Application for plugging filed November 14, 19 56  
Application for plugging approved November 15, 19 56  
Plugging commenced November 21, 19 56  
Plugging completed November 29, 19 56  
Reason for abandonment of well or producing formation Depleted formation.

NORTH

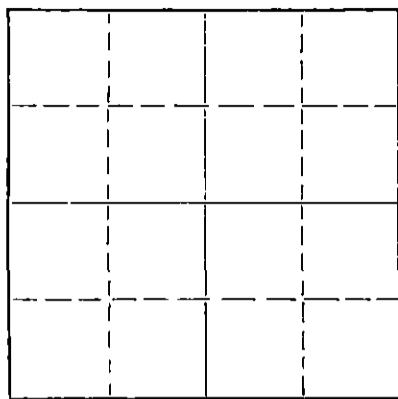

Locate well correctly on above  
Section Plat

If a producing well is abandoned, date of last production November 15, 19 56  
Was permission obtained from the Conservation Division or its agents before plugging was commenced? Yes

Name of Conservation Agent who supervised plugging of this well R. M. Brundage  
Producing formation Arbuckle Depth to top 4405 Bottom 4413 Total Depth of Well 4413 Feet  
Show depth and thickness of all water, oil and gas formations.

OIL, GAS OR WATER RECORDS

CASING RECORD

FORMATION	CONTENT	FROM	TO	SIZE	PUT IN	PULLED OUT
				8-5/8"	324'	None
				5-1/2"	4406'	2206'

Describe in detail the manner in which the well was plugged, indicating where the mud fluid was placed and the method or methods used in introducing it into the hole. If cement or other plugs were used, state the character of same and depth placed, from \_\_\_\_\_ feet to \_\_\_\_\_ feet for each plug set.

4413-4390', river sand.  
4390-4350', 5 sacks cement.  
4350- 270', mud.  
270- 180', rock bridge and 25 sacks cement.  
180- 35', mud.  
35' to base cellar, rock bridge and 10 sacks cement.

RECEIVED  
STATE CORPORATION COMMISSION  
DEC - 8 1956  
12 - 8 - 56  
CONSERVATION DIVISION  
Wichita, Kansas

(If additional description is necessary, use BACK of this sheet)  
Name of Plugging Contractor C. E. Shull Casing Pulling Co.  
Address Box 558, Great Bend, Kansas

STATE OF Kansas, COUNTY OF Barton, ss.  
V. M. Conover (employee of owner) or owner or operator of the above-described well, being first duly sworn on oath, says: That I have knowledge of the facts, statements, and matters herein contained and the log of the above-described well as filed and that the same are true and correct. So help me God.

(Signature) V. M. Conover  
Box 144, Great Bend, Kansas  
(Address)

SUBSCRIBED AND SWORN to before me this 7th day of December, 19 56

W. J. Smith  
Notary Public.

My commission expires March 12, 1959.

PLUGGING  
FILE SEC 35 T 24 R 15 W  
BOOK PAGE 116 LINE 19

# WELL RECORD

Company Cities Service Oil Co. Well No. 3 Farm Darstow  
 Location 990' South and 660' East of 1/4 Corner Sec. 35 T. 24 R. 15W  
 Elevation 2018 (2016 Cr.) County Stafford State Kansas  
 Drlg. Comm. September 17, 1950 Contractor Holm Drilling Company  
 Drlg. Comp. October 5, 1950 Acid 500 gals. 10-6-50  
 T. D. 4413' Initial Prod. Pumped 55 oil, 165 water, 24 hrs. (10-9-50)

CASING RECORD:

2-5/8" @ 324' cen. 250 ex cement  
 5-1/2" @ 4406' cen. 200 ex cement

FORMATION RECORD:

surface soil	0-10
clay	25
sand	45
sand & shale	65
shale & red bed	200
shale & shells	324
red bed & shale	440
sand & shale	490
red bed & shale	790
anhydrite	960
shale & shale	1810
lime & shale	2465
shale & lime	2620
lime & shale	2765
shale, lime & shells	2930
shale & lime	3075
lime & shale	3165
lime	3475
lime & shale	3552
lime	3590
lime & shale	3790
lime	4172
shale & lime	4200
lime & shale	4223
lime, shale & chert	4253
lime & chert	4296
lime & shale	4310
shale & lime	4339
sand & shale	4350
shale & lime	4406

4406 MID = 4407 SLN' E.D.  
 4413' D.

Corr. Top Lansing	3747'
Corr. Top Conglomerate	4125'
Corr. Top Kinderhook	4130'
Corr. Top Viola	4195'
Corr. Top Simpson Sand	4328'
Corr. Top Arbuckle	4405'
Penetration	8'
Total Depth	4413'

3 gals. oil and 15 gals. water  
 per hr. for 13 hrs.

SYFO: 500' 0°  
 1000' 0°  
 1500' 1°  
 2000' 0°  
 2500' 1°  
 3000' 0°  
 3500' 0°  
 4000' 1°

**PLUGGING**

FILE SEC 35 T. 24 R. 15W

BOOK PAGE 116 LINE 19

STAFFORD COUNTY COMMISSION  
 1st Flr., Bldg. No. 1

