

STATE OF KANSAS
- STATE CORPORATION COMMISSION

Give All Information Completely
Make Required Affidavit
Mail or Deliver Report to:
Conservation Division
State Corporation Commission
211 No. Broadway
Wichita, Kansas


WELL PLUGGING RECORD

Stafford

County, Sec. 35 Twp. 24S Rge. 15W (W)

Location as "NE/CNWSWK" or footage from lines SE SE NE
Lease Owner D. R. Lauck Oil Company, Inc.
Lease Name Giles Well No. 1
Office Address 301 S. Broadway, Wichita, Kansas
Character of Well (completed as Oil, Gas or Dry Hole) Dry Hole
Date well completed January 5, 1962
Application for plugging filed January 5, 1962
Application for plugging approved January 5, 1962
Plugging commenced January 5, 1962
Plugging completed January 5, 1962
Reason for abandonment of well or producing formation Dry Hole

NORTH

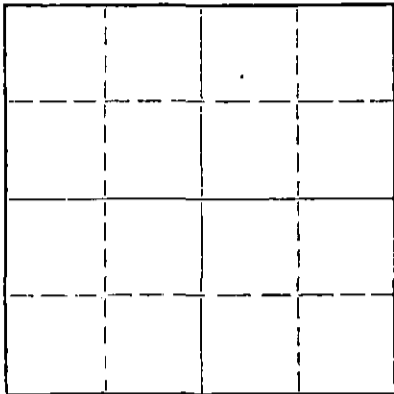

Locate well correctly on above Section Plat

If a producing well is abandoned, date of last production 19
Was permission obtained from the Conservation Division or its agents before plugging was commenced? Yes

Name of Conservation Agent who supervised plugging of this well W. L. Lockemp
Producing formation Depth to top Bottom Total Depth of Well 4497 Feet
Show depth and thickness of all water, oil and gas formations.

OIL, GAS OR WATER RECORDS

CASING RECORD

FORMATION	CONTENT	FROM	TO	SIZE	PUT IN	PULLED OUT
		0'	224'	8-5/8"	224'	None

Describe in detail the manner in which the well was plugged, indicating where the mud fluid was placed and the method or methods used in introducing it into the hole. If cement or other plugs were used, state the character of same and depth placed, from feet to feet for each plug set.

4497-212' Mud
212-208' Plug
208'-35' Cement & Mud, 20 sacks
35- 31' Plug
31- 6' Cement (Bottom of Cellar)

RECEIVED
STATE CORPORATION COMMISSION
2-9-62
FEB 9 1962
CONSERVATION DIVISION

Name of Plugging Contractor (If additional description is necessary, use BACK of this sheet)
Globe Cementing Co.
Address Great Bend, Kansas

STATE OF KANSAS, COUNTY OF SEDGWICK, ss.
John H. Knightley (employee of owner) or (owner or operator) of the above-described well, being first duly sworn on oath, says: That I have knowledge of the facts, statements, and matters herein contained and the log of the above-described well as filed and that the same are true and correct. So help me God.

(Signature) John H. Knightley
301 S. Broadway, Wichita, Kansas
(Address)

SUBSCRIBED AND SWORN TO before me this 8th day of February, 1962

My commission expires March 12, 1963
Stella J. Bodine Notary Public.

D. R. Lauck Oil Company, Inc.

Giles #1

SE SE NE Sec. 35-^{24S-15W}~~30S-15W~~
Stafford County, Kansas

Commenced: December 21, 1961
Completed: January 5, 1962

Casing Record: 224' 8-5/8" Cemented w/170 sacks cement,
4 sacks Calcium Chloride.

Elevation: GL 2007; DF 2010; KB 2012.

Drillers Log

Tops

Clay	25		Schlumberger
Sand	157	Heebner	3596-1584
Shale	270	Toronto	3616-1604
Red Bed	425	Douglas	3634-1622
Sand	475	Brown Lime	3748-1736
Red Bed	947	Lansing-Kansas City	3757-1745
Anhydrite	975	Base Kansas City	4045-2033
Red Bed	1170	Conglomerate	4151-2139
Red Bed, Shale & Shells	1780	Mississippian	4158-2146
Shale & Shells	1820	Kinderhook	4193-2181
Anhydrite	1950	Kinderhook-Viola	4233-2222
Lime & Shale	2595	True Viola	4275-2263
Shale & Lime	2760	Simpson Shale	4352-2340
Shale & Shells	2930	Simpson Sand	4368-2356
Shale	3035	Arbuckle	4429-2417
Lime & Shale	3220	Rotary Total Depth	4492-2480
Broken Lime	3370	Driller Total Depth	4497-2485
Lime	3515		
Shale	3606	DST #1 (H) 4162-4170, open 1 hr. w/strong	
Lime	3690	blow, gas to surface in 2 minutes	
Shale	3751	too small to measure. Recovered	
Lime	4065	30' gas-cut mud.	
Lime & Shale	4110	ISIP 1405# 20 min.	
Lime	4155	FSIP 1365# 30 min.	
Mississippian	4160	FP 10-20#	
Shale & Chert =	4170		
Mississippi Chert	4197	DST #2 (W) 4170-4205, open 1 hr. w/strong	
Kinderhook	4205	blow, gas to surface in 6 minutes	
Shale	4225	too small to measure. Recovered	
Shale, Lime & Chert	4285	180' thin gas-cut mud.	
Viola Chert	4320	ISIP 1399# 20 min.	
Chert & Lime	4355	FSIP 1409# 30 min.	
Shale, Chert & Sand	4405	FP 85-85#	
Simpson	4433		
Arbuckle	4497 RTD		

RECEIVED
STATE CORPORATION COMMISSION

D&A

FEB 9 1962

CONSERVATION DIVISION,
Wichita, Kansas.