


STATE OF KANSAS
STATE CORPORATION COMMISSION
200 Colorado Derby Bldg.
Wichita, Kansas 67202

Form CP-4
Rev. 12-15-80

WELL PLUGGING RECORD

Give All Information Completely
Make Required Affidavit

COUNTY Stafford SEC. 26 TWP. 24S RGE. 15W E/W
Location as in quarters or footage from lines:
E/2 E/2 NE

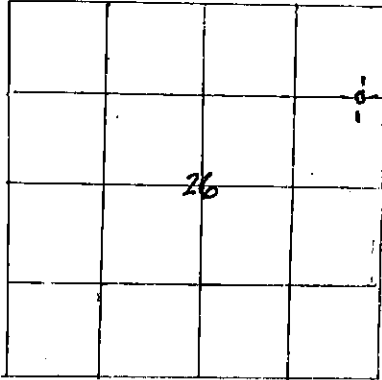

Lease Owner Alpine Drilling Co., Inc.
Lease Name Blount Well No. 1
Office Address 200 E. First, Suite 500, Wichita, KS 67202
Character of Well (Completed as Oil, Gas or Dry Hole): Dry Hole
Date Well Completed September 3, 1982
Application for plugging filed September 3, 1982
Plugging commenced September 3, 1982
Plugging completed September 3, 1982
Reason for abandonment of well or producing formation _____

Locate Well
correctly on above
Section Platt.

Was permission obtained from the Conservation Division or it's
Agent's before plugging was commenced? yes

Name of Conservation Agent who supervised plugging of this well Steve Durrant
Producing formation _____ Depth to top _____ bottom _____ T.D. 4460

Show depth and thickness of all water, oil and gas formations.

OIL, GAS OR WATER RECORDS

Casing Record

Formation	Content	From	To	Size	Put in	Pulled Out
Surface	shale	0	307	8-5/8"	303	none
	cemented with 225 sx common, 2% gel, 3% cc plug down at 6:45 p.m. 8-26-82 by Sun					

Describe in detail the manner in which the well was plugged, indicating where the mud
fluid was placed and the method or methods used in introducing it into the hold. If cement
or other plugs were used, state the character of same and depth placed, from _____ feet
to _____ feet for each plug set.

Plugged as follows with 70 sx @ 900'
40 sx @ 330'
10 sx @ 40' w/solid bridge plug
10 sx in rat hole & 5 sx water well
completed by Sun @ 3:15 a.m. 9-3-82

(If additional description is necessary, use BACK of this sheet)

Name of Plugging Contractor J. W. Drilling Co., Inc.

STATE OF KANSAS COUNTY OF SEDGWICK, ss.

Jon T. Williams, Jr. (employee of owner) or (owner or operator) of the
above-described well, being first duly sworn on oath, says: That I have knowledge of the
facts, statements, and matters herein contained and the log of the above-described well as
filed and that the same are true and correct. So help me God.

(Signature) [Signature]
200 East First, Suite 500, Wichita, KS
(Address)

My Commission Expires _____ SWORN TO before me this 3rd day of September 1982

My Commission Expires _____ January 14, 1985

Geraldine Stewart
Geraldine Stewart Notary Public.



Rec'd
9-10-82