


STATE OF KANSAS
STATE CORPORATION COMMISSION

WELL PLUGGING RECORD

Give All Information Completely
Make Required Affidavit
Mail or Deliver Report to:
Conservation Division
State Corporation Commission
211 No. Broadway
Wichita, Kansas

Stafford County, Sec. 15 Twp. 24 Rge. 15 ~~XX~~ (W)
Location as "NE/CNW/SW" or footage from lines SE SE SE
Lease Owner D. R. Lauck Oil Company, Inc. - Sunray Mid-Cont.
Lease Name Suiter Well No. 1-A
Office Address 301 So. Broadway Wichita, Kans
Character of Well (completed as Oil, Gas or Dry Hole) dry hole
Date well completed March 24 19 56
Application for plugging filed March 24 19 56
Application for plugging approved March 24 19 56
Plugging commenced March 24 19 56
Plugging completed March 24 19 56
Reason for abandonment of well or producing formation dry hole

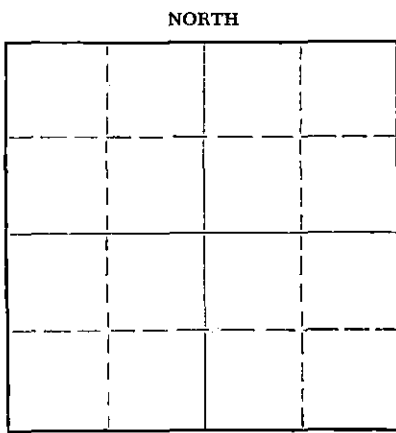

Locate well correctly on above
Section Plat

If a producing well is abandoned, date of last production 19
Was permission obtained from the Conservation Division or its agents before plugging was commenced? yes

Name of Conservation Agent who supervised plugging of this well R. M. Brundoge
Producing formation -- Depth to top --- Bottom --- Total Depth of Well 4426 Feet
Show depth and thickness of all water, oil and gas formations.

OIL, GAS OR WATER RECORDS				CASING RECORD		
FORMATION	CONTENT	FROM	TD	SIZE	PUT IN	PULLED OUT
		198	0	8 5/8	198	none

Describe in detail the manner in which the well was plugged, indicating where the mud fluid was placed and the method or methods used in introducing it into the hole. If cement or other plugs were used, state the character of same and depth placed, from _____ feet to _____ feet for each plug set.

Hole filled with mud, plug and 90 sacks cement pumped on top of mud;

Handwritten notes:
3-31-56
3-31-56

(If additional description is necessary, use BACK of this sheet)
Name of Plugging Contractor Globe Oil Well Cementing Co.
Address Great Bend, Kansas

STATE OF Kansas, COUNTY OF Sedgwick, ss.
John H. Knightley (employee of owner) or ~~owner~~ operator of the above-described well, being first duly sworn on oath, says: That I have knowledge of the facts, statements, and matters herein contained and the log of the above-described well as filed and that the same are true and correct. So help me God?

(Signature) John H. Knightley
Wichita Kansas
(Address)

SUBSCRIBED AND SWORN TO before me this 28 day of March, 19 56

My commission expires Sept. 14, 1959
Elizabeth Gay Notary Public

PLUGGING
FILE SEC. 15 T. 24 R. 15W
BOOK PAGE 48 LINE 20

D. R. Lauck Oil Company, Inc. and
Sunray Mid-Continent Oil Company

Suiter #1-A
SE SE SE Sec. 15-24S-15W
Stafford County, Kans

Commenced: March 9, 1956
Completed: March 24, 1956

Casing Record: 198' 8 5/8" cemented w/175 sx
Elevation: GR 2015; DF 2018; KB 2020;

Drillers Log

Surface Clay	20
shale sand	130
shale & shells	198
shale	365
sand	510
red bed & sand	655
red bed, shale & shells	975
Anhydrite	995
shale & shells	1120
salt & shale	1320
shale & shells	1790
lime & shale	3540
lime	3574
lime & shale	3625
shale	3650
shale & shells	3720
lime	3991
lime & shale	4090
shale, lime & chert	4145
shale & Cherty lime	4295
shale & sand	4330
shale	4365
Arbuckle	4426
rotary total depth	4426

	<u>Sample</u>	<u>Tops</u>	<u>Halliburton</u>
Anhydrite		975+1046	970+1051
Heebner		3565-1544	3560-15329
Brown Lime		3708-1687	3706-1685
Lansang K C		3720-1699	3716-1695
Base KC		3991-1970	3991-1970
Viola		4125-2104	4124-2103
Simpson shale		4288-2267	4297-2276
Arbuckle		4365-2344	4364-2343
Rotary Total Depth		4426-2405	4425-2404

DST #1 4286-4330 weak blow 50 min.
open 1 hr; recovered 60'
drilling mud; IFP 0%; FFP 0%;
BHP 1250# in 30 min.

D & A
FILE
STATE COMMISSION
MAR 31 1956
CONSERVATION DIVISION
Wichita, Kansas

I hereby certify that this is a true and correct log of the No. 1-A Suiter well to the best of my knowledge and belief.

John H. Knightley
John H. Knightley

Subscribed and sworn to before me this 29th day of March 1956.

Elizabeth Gay
Notary Public

My commission expires: Sept. 14, 1959.

PLUGGING
TRK SEC 15 T 24 R 15W
BOOK PAGE 48 LINE 20