


Give All Information Completely
Make Required Affidavit
Mail or Deliver Report to:
Conservation Division
State Corporation Commission
211 No. Broadway
Wichita, Kansas

WELL PLUGGING RECORD

Stafford County, Sec. 15 Twp. 24 Rge. (E) 15 (W)

Location as "NE/CNW/SW" or footage from lines NW NW SE
Lease Owner Addis Oil Operations
Lease Name Cummins Well No. 1
Office Address Box 519, Great Bend, Kansas
Character of Well (completed as Oil, Gas or Dry Hole) dry hole
Date well completed January 24 1966
Application for plugging filed January 25 1966
Application for plugging approved 19
Plugging commenced 9:15 a.m., January 24, 1966
Plugging completed 11:15 a.m., January 24 1966
Reason for abandonment of well or producing formation dry hole

NORTH

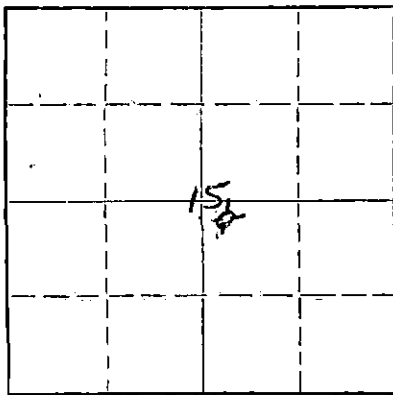

Locate well correctly on above
Section Plat

If a producing well is abandoned, date of last production 19
Was permission obtained from the Conservation Division or its agents before plugging was commenced? yes

Name of Conservation Agent who supervised plugging of this well ARCHIE Archie Elving
Producing formation _____ Depth to top _____ Bottom _____ Total Depth of Well _____ Feet
Show depth and thickness of all water, oil and gas formations.

OIL, GAS OR WATER RECORDS

CASING RECORD

FORMATION	CONTENT	FROM	TO	SIZE	PUT IN	PULLED OUT
		0'	201'	8 5/8"	201'	none

Describe in detail the manner in which the well was plugged, indicating where the mud fluid was placed and the method or methods used in introducing it into the hole. If cement or other plugs were used, state the character of same and depth placed, from _____ feet to _____ feet for each plug set.
Bottom plug @ 190' with 1/4 sack hulls and 25 sx cement.
Top plug @ 40' with plug and 10 sx cement.
2 sx cement in rat hole.

RECEIVED
STATE CORPORATION COMMISSION
1-26-66
JAN 26 1966
1-26-66
CONSERVATION DIVISION
Wichita, Kansas

(If additional description is necessary, use BACK of this sheet)
Name of Plugging Contractor Vaughan Drilling, Inc.
Address Box 825, Great Bend, Kansas

STATE OF KANSAS, COUNTY OF BARTON, ss.
Wayne Dobbs (employee of owner) or (owner or operator) of the above-described

well, being first duly sworn on oath, says: That I have knowledge of the facts, statements, and matters herein contained and the log of the above-described well as filed and that the same are true and correct. So help me God.

(Signature) Wayne Dobbs
Box 825, Great Bend, Kansas
(Address)

SUBSCRIBED AND SWORN to before me this 25th day of January, 19 66
Delores Strecker
Delores Strecker Notary Public.

My commission expires August 27, 1969

WELL LOG

COMPANY Addis Oil Operations
 CONTRACTOR Vaughan Drilling, Inc.
 FARM #1 Cummins
 LOCATION NW NW SE of sec. 15-24-15W
 Stafford County, Kansas
 ELEVATION 2022' K. B.
 SURFACE PIPE 8 5/8" cemented at 201' with 175 sx posmix sunset.
 PRODUCTION D & A
 COMMENCED 1-12-66
 COMPLETED 1-24-66

<u>FORMATION</u>	<u>DEPTH</u>
Sandstone & Clay	85
Shale	201
Shale & Red Bed	400
Red Bed	420
Sandstone	490
Red Bed with sand streaks	966
Anhydrite	984
Shale & Shells	1650
Limestone & Shale	1965
Limestone & Shale with Sandy Stks.	2120
Limestone & Shale	3365
Limestone	3590
Limestone & Shale	3715
Limestone	3975
Limestone & Shale	4040
Limestone	4125
Chert & Limestone & Shale	4185
Shale	4200
Limestone & Shale	4226

FORMATION TOPS

Anhydrite	966 (+1056)
Heebner	3542 (-1520)
Toronto	3566 (-1544)
Douglas	3582 (-1560)
Brown Limestone	3686 (-1664)
Lansing	3696 (-1674)
Base Kansas City	3949 (-1927)
Viola	4077 (-2055)
Simpson	4147 (-2125)
Arbuckle	4221 (-2199)
Rotary Total Depth	4226 (-2204)

RECEIVED
 STATE CORPORATION COMMISSION

JAN 26 1966

A F F I D A V I T

STATE OF KANSAS, COUNTY OF BARTON, SS:

I, Wayne Dobbs, of the VAUGHAN DRILLING, INC., being first duly sworn on oath, state; that I have knowledge of the facts, statements and matters herein contained and that the same are true and correct.

Wayne Dobbs
 Wayne Dobbs, Vice-Pres.

Subscribed and sworn to before me this 24th day of January, 1966.

Delores Strecker
 Delores Strecker, Notary Public

My commission expires: August 27, 1969.