

CARD MUST BE TYPED

State of Kansas
NOTICE OF INTENTION TO DRILL

CARD MUST BE SIGNED

(see rules on reverse side)

Starting Date: 5/25/85
month day year

API Number 15-073-23, 426-00-00

OPERATOR: License # 5193
Name S. & B. Oil Operations
Address Box 365
City/State/Zip Madison, KS 66860
Contact Person George Sauder
Phone 316-437-2287

SW NE SE
(location) Sec 1 Twp 22 S, Rge 10 East West

1650 Ft North from Southeast Corner of Section
990 Ft West from Southeast Corner of Section
(Note: Locate well on Section Plat on reverse side)

CONTRACTOR: License # 5930
Name Franklin D. Gaines
City/State Augusta, KS 67010

Nearst lease or unit boundary line 990 feet.
County Greenwood
Lease Name Hess Jamison Well# 4

Well Drilled For: Well Class: Type Equipment:
 Oil Swd Infield Mud Rotary
 Gas Inj Pool Ext. Air Rotary
 OWWO Expl Wildcat Cable

Domestic well within 330 feet: yes no
Municipal well within one mile: yes no

If OWWO: old well info as follows:
Operator
Well Name
Comp Date Old Total Depth
Projected Total Depth 2600 feet
Projected Formation at TD Viola
Expected Producing Formations

Depth to Bottom of fresh water 25 feet
Lowest usable water formation Douglas Group
Depth to Bottom of usable water 200 feet
Surface pipe by Alternate: 1 2
Surface pipe to be set 200 feet
Conductor pipe if any required
Ground surface elevation 1200 feet MSL
This Authorization Expires 11-22-85
Approved By 5-22-85 [Signature]

I certify that we will comply with K.S.A. 55-101, et seq., plus eventually plugging hole to K.C.C. specifications.

Date 5/22/85 Signature of Operator or Agent Susan Arnold


Title As Agent

mhc/KOHE 5-22-85

Must be filed with the K.C.C. five (5) days prior to commencing well
 This card void if drilling not started within six (6) months of date received by K.C.C.

MAY 22 1985 5-22-85

STATE CORPORATION COMMISSION
 A Regular Section of Land
 1 Mile = 5,280 Ft.

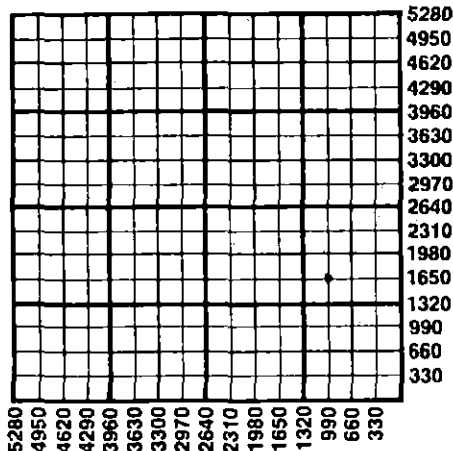

Important procedures to follow:

1. Notify District office before setting surface casing.
2. Set surface casing by circulating cement to the top.
3. File completion forms ACO-1 with K.C.C. within 90 days of well completion, following instructions on ACO-1, side 1, and including copies of wireline logs.
4. Notify District office 48 hours prior to old well workover or re-entry.
5. Prior to plugging, prepare a plugging plan, then obtain agreement from the appropriate district office for an approved plugging plan.
6. Submit plugging report (CP-4) to K.C.C. after plugging is completed.
7. Obtain an approved injection docket number before disposing of salt water.
8. Notify K.C.C. within 10 days when injection commences or terminates.
9. If an alternate 2 completion, cement in the production pipe from below any usable water to surface within 120 days of spud date.

State Corporation Commission of Kansas
 Conservation Division
 200 Colorado Derby Building
 Wichita, Kansas 67202
 (316) 263-3238