


STATE OF KANSAS
STATE CORPORATION COMMISSION
200 Colorado Derby Bldg.
Wichita, Kansas 67202

Form CP-4
Rev. 12-15-80

WELL PLUGGING RECORD

Give All Information Completely
Make Required Affidavit

COUNTY Stafford SEC. 7 TWP. 24S RGE. 12 ~~W~~
Location as in quarters or footage from lines:
60' W of SE NE SW

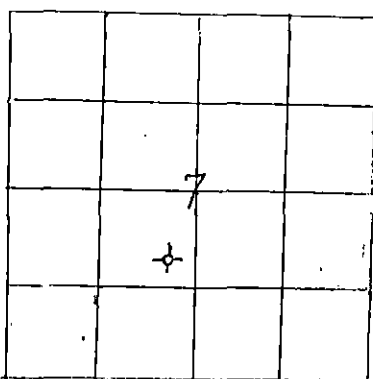

Lease Owner Texas Energies, Inc.
Lease Name Larry Ball Well No. 1-7
Office Address P.O. Box 947 Pratt, KS 67124
Character of Well (Completed as Oil, Gas or Dry Hole): Dry Hole
Date Well Completed 5-10-83
Application for plugging filed _____
Plugging commenced 5-10-83
Plugging completed 5-10-83
Reason for abandonment of well or producing formation
Dry Hole

Locate Well
correctly on above
Section Platt.

Was permission obtained from the Conservation Division or it's
Agent's before plugging was commenced? Yes

Name of Conservation Agent who supervised plugging of this well Steve Durrant
Producing formation --- Depth to top --- bottom --- T.D. 4130

Show depth and thickness of all water, oil and gas formations.

OIL, GAS OR WATER RECORDS

Casing Record

Formation	Content	From	To	Size	Put in	Pulled Out
				8 5/8	252	None

Describe in detail the manner in which the well was plugged, indicating where the mud
fluid was placed and the method or methods used in introducing it into the hold. If cement
or other plugs were used, state the character of same and depth placed, from _____ feet
to _____ feet for each plug set.


Plugged well with 130 sxs 60-40 poz 2% Gel 3% CC
as follows:

- 70 sxs at 900'
- 40 sxs at 270'
- solid bridge with wood and rubber plug + 10 sxs at 40'
- Circulated 10 sxs through rathole

(If additional description is necessary, use BACK of this sheet)

Name of Plugging Contractor Wheatstate Drilling

STATE OF Kansas COUNTY OF Pratt, ss.
E. H. Bittner (employee of owner) or ~~owner or operator~~ of the
above-described well, being first duly sworn on oath, says: That I have knowledge of the
facts, statements, and matters herein contained and the log of the above-described well as
filed and that the same are true and correct. So help me God.

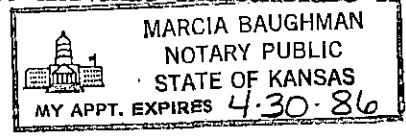

(Signature) E.H. Bittner
P.O. Box 947 Pratt, KS 67124
(Address)

SUBSCRIBED AND SWORN TO before me this 17th day of May, 19 83

My Commission expires: 4-30-86

RECEIVED
STATE CORPORATION COMMISSION
Marcia Baughman
Notary Public.
5-18-83
MAY 18 1983