


STATE OF KANSAS
STATE CORPORATION COMMISSION

WELL PLUGGING RECORD

Give All Information Completely
Make Required Affidavit
Mail or Deliver Report to:
Conservation Division
State Corporation Commission
800 Bittling Building
Wichita, Kansas

NORTH

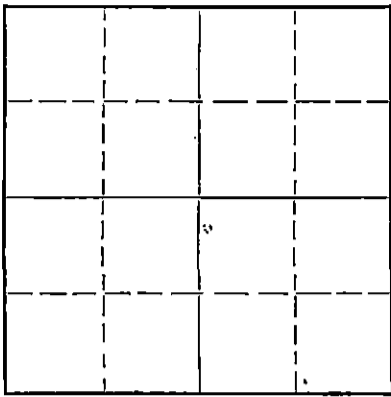

Locate well correctly on above
Section Plat

Stafford County, Sec. 7 Twp. 24 Rge. (E) 12 (W)
Location as "NE/CNW $\frac{1}{4}$ /SW $\frac{1}{4}$ " or footage from lines NE NE NW
Lease Owner Lockhart & Veeder Supply Company, Etal
Lease Name Bennett Well No. 1
Office Address 705 Union National Bank Bldg., Wichita, Kansas
Character of Well (completed as Oil, Gas or Dry Hole) Dry Hole
Date well completed May 7, 1952
Application for plugging filed May 7, 1952
Application for plugging approved May 7, 1952
Plugging commenced May 7, 1952
Plugging completed May 7, 1952
Reason for abandonment of well or producing formation

If a producing well is abandoned, date of last production 19
Was permission obtained from the Conservation Division or its agents before plugging was commenced? Yes

Name of Conservation Agent who supervised plugging of this well Merrel A. Reeves, Pratt, Kansas
Producing formation Depth to top Bottom Total Depth of Well 1090 Feet
Show depth and thickness of all water, oil and gas formations.

OIL, GAS OR WATER RECORDS

CASING RECORD

Formation	Content	From	To	Size	Put In	Pulled Out
				8-5/8"	283'	Cemented

Describe in detail the manner in which the well was plugged, indicating where the mud fluid was placed and the method or methods used in introducing it into the hole. If cement or other plugs were used, state the character of same and depth placed, from feet to feet for each plug set.

Filled hole to 270 feet with mud. Number 1 plug at
270 feet mixed 20 sacks of cement pored through the
drill pipe, filled hole with heavy mud to 35 feet.
Set number 2 plug at 35 feet mixed 10 sacks of
cement.

RECEIVED
STATE CORPORATION COMMISSION
JUN 14 1952
CONSERVATION DIVISION
Wichita, Kansas

(If additional description is necessary, use BACK of this sheet)
Name of Plugging Contractor Veeder Supply & Development Company
Address P. O. Box 201
Cherryvale, Kansas

STATE OF KANSAS, COUNTY OF MONTGOMERY, ss.
FLOYD W. HILD, (employee of owner) or (owner or operator) of the above-described well,
being first duly sworn on oath, says: That I have knowledge of the facts, statements, and matters herein contained and the log of the above-
described well as filed and that the same are true and correct. So help me God. THE VEEDER SUPPLY & DEVELOPMENT COMPANY
(Signature) Floyd W. Hild
P. O. Box 201, Cherryvale, Kansas (Address)

SUBSCRIBED AND SWORN to before me this 20th day of May 1952

Oles Lawson
Notary Public.

My commission expires July 11, 1952

PLUGGING
FILE SEC 77-260124
NOV 19 1952

Company Lockhart - Veeder Supply Company Et al

Sec. 7 T. 24 R. 12
Loc. NE/4 NW/4
County Stafford County, Kansas

Farm Bennett

No. 1

Total Depth 4090'

Comm. 4-24-52

Comp. 5-7-52


Shot or Treated

Contractor Veeder Supply & Dev. Co. Drilled with Rig - A

Issued

No. of Days - 14

No. of Bits -

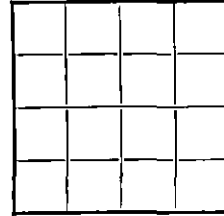

Casing

20 in. 10 in
15 1/2 8 1/4
12 1/2 6 5/8
13 3/8 5 3/16

Set 283' of 8-5/8" Casing Cemented with
165 sacks cement.

Elevation
Production

Figures Indicate Bottom of Formation

Sand Shale	0	40	40
Sand	40	150	110
Sand Shale Streaks	150	225	75
Shale	225	727	502
Anhydrite	727	760	33
Shale	760	785	25
Shale Shells	785	1740	955
Shale Lime Shells	1740	1825	85
Lime Shale	1825	2260	435
Shale Shells	2260	2350	90
Lime Shale	2350	2515	165
Shale Shells	2515	2855	340
Lime Shale	2855	3300	445
Lime	3300	3440	140
Lime Shale	3440	3480	40
Brown Lime	3480	3535	55
Lime	3535	3865	330
Lime Shale	3865	3890	25
Lime	3890	3905	15
Lime Chert	3905	3945	40
Lime	3945	3995	50
Lime Shale	3995	4015	20
Lime	4015	4090	75
Total Depth	4090'		

Tops:

Heebner - 3341
Lansing-KC - 3508
Viola - 3883
Arbuckle - 4067

Plugged at 270 feet with 20 sacks
cement.

Plugged at 35 feet with 10 sacks
cement.

PLUGGING
SEC 7 T 24 R 12
PAGE 14 LINE 33

RECEIVED
STATE CORPORATION COMMISSION
JUN 14 1952
CONSERVATION DIVISION
Wichita, Kansas