

STATE OF KANSAS
STATE CORPORATION COMMISSION

Form CP-4


Give All Information Completely
Make Required Affidavit
Mail or Deliver Report to:
Conservation Division
State Corporation Commission
212 No. Market
Wichita, Kansas

WELL PLUGGING RECORD

Reno County, Sec. 25 Twp. 22S Rge. (X) 10 (W)

Location as "NE/CNW/SW" or footage from lines SW SE NE
Lease Owner Jay Bee Oil Company
Lease Name Sleeper Well No. "B" #1
Office Address 515 Union Center, Wichita, Kansas
Character of Well (completed as Oil, Gas or Dry Hole) Dry Hole
Date well completed November 4, 1967
Application for plugging filed November 4, 1967
Application for plugging approved November 4, 1967
Plugging commenced November 4, 1967
Plugging completed November 4, 1967
Reason for abandonment of well or producing formation

NORTH

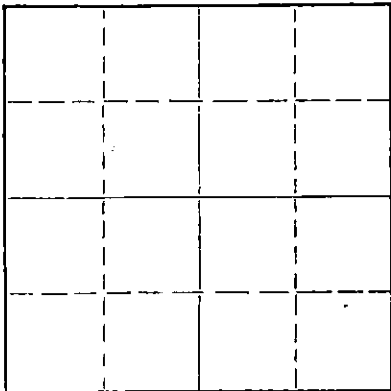

Locate well correctly on above
Section Plat

If a producing well is abandoned, date of last production 19
Was permission obtained from the Conservation Division or its agents before plugging was commenced? Yes

Name of Conservation Agent who supervised plugging of this well Herman E. Justus, Nickerson, Kansas
Producing formation Depth to top Bottom Total Depth of Well 3735 Feet
Show depth and thickness of all water, oil and gas formations.

OIL, GAS OR WATER RECORDS

CASING RECORD

FORMATION	CONTENT	FROM	TO	SIZE	PUT IN	PULLED OUT
				8-5/8"	247'	None

Describe in detail the manner in which the well was plugged, indicating where the mud fluid was placed and the method or methods used in introducing it into the hole. If cement or other plugs were used, state the character of same and depth placed, from feet to feet for each plug set.

Mudded up with heavy mud to 225 feet. Followed by wooden plug and 1/2 sack hulls. Placed 25 sacks cement onto hulls. Mudded up with heavy mud to 40 feet followed by wooden plug, 1/2 sack hulls and 10 sacks cement to base of well cellar. Plugged rat hole with 2 sacks cement.

FILED
NOV 8 1967
11-8-67
CONSERVATION DIVISION
WICHITA, KANSAS

(If additional description is necessary, use BACK of this sheet)

Name of Plugging Contractor Graves Drilling Co., Inc.
Address 505 Union Center, Wichita, Kansas

STATE OF KANSAS, COUNTY OF SEDGWICK, ss.
John C. Graves (employee of owner) or (owner or operator) of the above-described

well, being first duly sworn on oath, says: That I have knowledge of the facts, statements, and matters herein contained and the log of the above-described well as filed and that the same are true and correct. So help me God.

(Signature) John C. Graves
505 Union Center, Wichita, Kansas 67202
(Address)

SUBSCRIBED AND SWORN TO before me this 7th day of November, 1967

My commission expires May 9, 1971
Betty Brandt Notary Public.

ROTARY DRILLERS' LOG

OPERATOR: Jay Bee Oil Company
515 Union Center
Wichita, Kansas

DRILLING COMMENCED: October 26, 1967

CONTRACTOR: Graves Drilling Co., Inc.
505 Union Center
Wichita, Kansas

DRILLING COMPLETED: November 4, 1967

CASING RECORD: 6 Jts. 247' 8-5/8"
cemented with 250 sacks

LOCATION: Sleeper "B" No. 1
SW SE NE
Section 25-22S-10W
Reno County, Kansas

0 - 210	Sand	3125 - 3154	Lime & shale
210 - 247	Shale & red bed	3154 - 3449	Lime
247 - 382	Anhydrite	3449 - 3498	Lime & cherty shale
382 - 785	Shale, shells & red bed	3498 - 3503	Lime
785 - 1242	Shale & shells	3503 - 3554	Lime & shale
1242 - 1307	Shale & lime	3554 - 3644	Lime
1307 - 2155	Lime & shale	3644 - 3652	Shale
2155 - 2575	Shale & lime	3652 - 3660	Sand
2575 - 2685	Lime & shale	3660 - 3682	Lime
2685 - 2984	Lime	3682 - 3712	Sand, sandy shale & shale
2984 - 2990	Shale	3712 - 3721	Lime
2990 - 2998	Lime	3721 - 3733	Shale & sand
2998 - 3008	Sand	3733 - 3735	Dolomite
2008 - 3125	Sandy shale	3735	Rotary Total Depth

I hereby certify the foregoing statements to be true and correct to the best of my knowledge.

GRAVES DRILLING CO., INC.

By

John Graves
President

*Paid
11-8-67*

STATE OF KANSAS)
SEDGWICK COUNTY) SS:

Subscribed and sworn to before me, a Notary Public, this 7th day of November, 1967.

Betty Brandt
Betty Brandt Notary Public

My commission expires: May 9, 1971