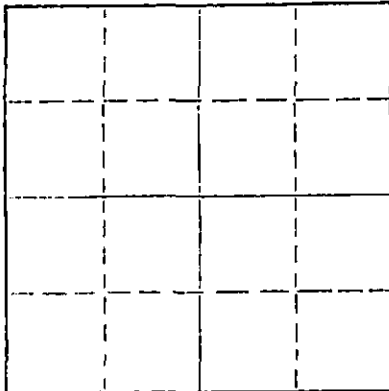


STATE OF KANSAS
STATE CORPORATION COMMISSION

Form CP-4

Give All Information Completely
Make Required Affidavit
Mail or Deliver Report to:
Conservation Division
State Corporation CommissionP. O. Box 17027
Wichita, Kansas 67217
NORTH

WELL PLUGGING RECORD

Locate well correctly on above
Section Plat

Reno

County. Sec. 25 Twp. 22S Rge. (E) 10 (W)

Location as "NE/CNW/SE/SW" or footage from lines NW NW SE

Lease Owner Rains & Williamson Oil Co., Inc.

Lease Name Sleeper Well No. #1

Office Address 435 Page Court, 220 W. Douglas, Wichita, Kans. 67202

Character of Well (completed as Oil, Gas or Dry Hole) Dry Hole

Date well completed 3-25-77 19

Application for plugging filed 3-25-77 19

Application for plugging approved 3-25-77 19

Plugging commenced 3-25-77 19

Plugging completed 3-25-77 19

Reason for abandonment of well or producing formation
Commercial quantities of oil not found

If a producing well is abandoned, date of last production 19

Was permission obtained from the Conservation Division or its agents before plugging was commenced? Yes

Name of Conservation Agent who supervised plugging of this well Gilbert Toman, Holyrood, Kansas

Producing formation Depth to top Bottom Total Depth of Well 3730' Feet

Show depth and thickness of all water, oil and gas formations.

OIL, GAS OR WATER RECORDS

CASING RECORD

FORMATION	CONTENT	FROM	TO	SIZE	PUT IN	PULLED OUT
				8 5/8"	250'	None

Describe in detail the manner in which the well was plugged, indicating where the mud fluid was placed and the method or methods used in introducing it into the hole. If cement or other plugs were used, state the character of same and depth placed, from feet to feet for each plug set.

Plug @ 500' w/40 sx.

Plug @ 240' w/25 sx.

Plug @ 40' w/10 sx.

RECEIVED
STATE COMMISSIONAPR 4 5 1977
4-15-77
CONSERVATION DIVISION
Wichita, KansasName of Plugging Contractor Rains & Williamson Oil Co., Inc.
(If additional description is necessary, use BACK of this sheet)

Address 435 Page Court, 220 W. Douglas, Wichita, Kansas 67202

STATE OF Kansas, COUNTY OF Sedgwick, ss.

Wilson Rains, President of Rains & Williamson Oil Co., Inc. (employee of owner) or (owner or operator) of the above-described well, being first duly sworn on oath, says: That I have knowledge of the facts, statements, and matters herein contained and the log of the above-described well as filed and that the same are true and correct. So help me God.

(Signature)

435 Page Court, 220 W. Douglas, Wichita, Kans. 67202
(Address)

Subscribed and sworn to before me this 12 day of April 1977

My commission expires 10-4-79

Juanita M. Green

Notary Public.

DRILLER'S LOG

15-155-20364-0000

COMPANY: Rains & Williamson Oil Co., Inc.

SEC. 25 T. 22S R. 10W

LOC. NW NW SE

WELL NAME: Sleeper #1

COUNTY: Reno

RIG NO. #3

TOTAL DEPTH 3730'

ELEVATION 1748 KB

COMMENCED: 3-17-77

COMPLETED: 3-25-77

CONTRACTOR: Rains & Williamson Oil Co., Inc.

CASING RECORD:

SURFACE: 8 5/8" @ 250' w/200 sx. common, 3% cc., 2% gel.

PRODUCTION: D&A

LOG

(Figures Indicate Bottom of Formations)

Redbed & Shale	952
Shale	1473
Lime & Shale	1614
Shale & Lime	1854
Lime & Shale	2040
Lime	2170
Shale & Lime	2385
Lime	2617
Lime & Sand	2671
Sand & Lime	2740
Lime	3730
<u>ROTARY TOTAL DEPTH</u>	<u>3730</u>

RECEIVED
STATE COMMISSION
APR 15 1977
CONSERVATION DIVISION
Wichita, Kansas

STATE OF Kansas)

COUNTY OF Sedgwick)

SS:

I, Wilson Rains, President of Rains & Williamson Oil Co., Inc.

upon oath state that the above and foregoing is a true and correct copy of the log of the
Sleeper #1 well.

Wilson Rains

Wilson Rains

Subscribed and sworn to before me this 12 day of April, 19 77.

My Appointment Expires:

10-4-79

Juanita M. Green
Juanita M. Green