


STATE OF KANSAS  
 STATE CORPORATION COMMISSION  
 Give All Information Completely  
 Make Required Affidavit  
 Mail or Deliver Report to:  
 Conservation Division  
 State Corporation Commission  
 800 Bitting Building  
 Wichita, Kansas

15-155-00343-0000  
**WELL PLUGGING RECORD**  
 Reno County. Sec. 21 Twp. 23 Rge. (E) 5 (W)

*Rec'd  
 4-21-54*

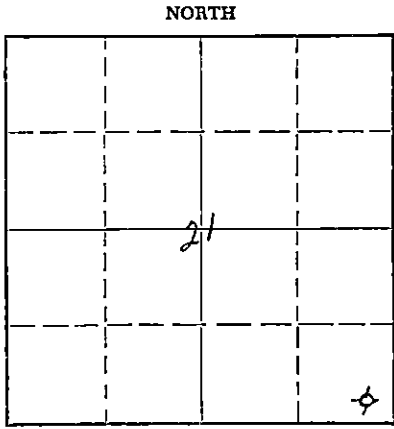

Locate well correctly on above Section Plat

Location as "NE/CNW/SW" or footage from lines SE SE SE  
 Lease Owner Brooks Pierce, et al  
 Lease Name Swanson "B" Well No. 1  
 Office Address 1208 Union National Bank Building, Wichita 2, Kansas  
 Character of Well (completed as Oil, Gas or Dry Hole) Dry Hole  
 Date well completed April 6 1954  
 Application for plugging filed April 6 1954  
 Application for plugging approved April 6 1954  
 Plugging commenced April 7 1954  
 Plugging completed April 7 1954  
 Reason for abandonment of well or producing formation Dry Hole

If a producing well is abandoned, date of last production \_\_\_\_\_ 19\_\_\_\_  
 Was permission obtained from the Conservation Division or its agents before plugging was commenced? Yes

Name of Conservation Agent who supervised plugging of this well Ruel Durkee  
 Producing formation \_\_\_\_\_ Depth to top \_\_\_\_\_ Bottom \_\_\_\_\_ Total Depth of Well 3975 Feet  
 Show depth and thickness of all water, oil and gas formations.

**OIL, GAS OR WATER RECORDS** **CASING RECORD**

FORMATION	CONTENT	FROM	TO	SIZE	PUT IN	PULLED OUT
				13 3/8"	90'	None
				8 5/8"	749'	None

Describe in detail the manner in which the well was plugged, indicating where the mud fluid was placed and the method or methods used in introducing it into the hole. If cement or other plugs were used, state the character of same and depth placed, from \_\_\_\_\_ feet to \_\_\_\_\_ feet for each plug set.

3975 - 215 Heavy Rotary Mud  
215 - 175 Solid Bridge with Rock and 15 sacks of cement  
175 - 30 Heavy Mud  
30 - Surface Bridge, Rock, and 5 sacks of cement

(If additional description is necessary, use BACK of this sheet)

Name of Plugging Contractor Thos. H. Allan  
 Address 1221 Union National Bank Building, Wichita 2, Kansas

STATE OF KANSAS, COUNTY OF SEDGWICK, ss.  
Brooks Pierce (employee of owner) or (owner or operator) of the above-described well, being first duly sworn on oath, says: That I have knowledge of the facts, statements, and matters herein contained and the log of the above-described well as filed and that the same are true and correct. So help me God.

(Signature) Brooks Pierce  
1208 Union National Bank Bldg., Wichita, Kansas  
 (Address)

SUBSCRIBED AND SWORN TO before me this 23rd day of April, 1954

My commission expires Sept 9, 1954  
Louise L. Bowman  
 Notary Public.

24-7968-6 3-53-20M

**PLUGGING**  
 FILE SEC 21 T 23 R 5W  
 BOOK PAGE 26 LINE 33

In lieu of Driller's Log

**BENTON S. BROOKS, JR.**

PETROLEUM GEOLOGIST

WICHITA-8, KANSAS

April 22, 1954

15-155-00343-0000

Re: Brooks Pierce  
Swanson "B" No. 1  
SE SE SE Sec. 21-23S-5W  
Reno County, Kansas

Mr. Brooks Pierce  
Union National Bank Bldg.  
Wichita 2, Kansas

Dear Mr. Pierce:

The information derived from the drilling of the above captioned well has been correlated to rotary bushing measurements and is as follows:

Elevation:	1516	
90 Feet of 13-3/8" cemented with 70 sacks		
749 Feet of 8-5/8" cemented with 250 sacks		
Top of Heebner Shale:	2502	(-986)
Top of Toronto:	2524	(-1008)
Top of Douglass:	2581	(-1015)
Top of Brown Lime:	2690	(-1174)
Top of Lansing:	2718	(-1202)
Base of Kansas City:	3164	(-1648)
Top of Marmaton:	3177	(-1661)
Top of Cherokee:	3310	(-1794)
Top of Sooy Conglomerate:	3389	(-1873)
Top of Mississippi (Warsaw):	3390	(-1874)
Top of Mississippi (Osage):	3400	(-1884)

(Circulated samples at 3402, contained granular dolomitic lime with pin-points of live oil)

(Drilling sample 3405 to 3410 contained cuttings of spongy oil stained dolomitic lime)

(Drilling sample 3440 to 3445 contained cuttings of white cherty lime, bleeding black live oil)

Drill Stem Test: 3393 to 3455, open 1 hour, good blow, recovered a slight show of gas and 1470 feet of salt water. Bottom Hole Pressure: 890 pounds.

Top of Kinderhook:	3622	(-2106)
Top of Misener Sand:	3738	(-2222)

(Medium size rounded sand with live oil saturation and fair oil odor in 50% of the cuttings)

Top of Hunton:	3743	(-2227)
Top of Maquoketa:	3776	(-2260)

**PLUGGING**  
FILE SEC 21-23-5W  
BOX PAGE 26 LINE 33

STATE CORPORATION COMMISSION

APR 24 1954  
STATE CORPORATION COMMISSION

15-155-00343-0000

Mr. Brooks Pierce

- 2 -

April 22, 1954

Top of Viola: 3847 (-2331)  
Top of Simpson: 3871 (-2355)

(Fine dolomitic sand with included gilsonite, no live oil and no oil odor  
3871 to 3879)

Top of Arbuckle: 3956 (-2440)

(Tan coarse crystalline, porous, drusy dolomite)

Total Depth: 3975 (-2459)

Plugged and abandoned on April 7, 1954.

Sincerely yours,

*Benton S. Brooks, Jr.*  
Benton S. Brooks, Jr.

BSB/lw