

STATE OF KANSAS  
STATE CORPORATION COMMISSION


WELL PLUGGING RECORD

Give All Information Completely  
Make Required Affidavit  
Mail or Deliver Report to:  
Conservation Division  
State Corporation Commission  
800 Bittling Building  
Wichita, Kansas

Stafford County. Sec. 17 Twp. 24S Rge. 12 (E) 12 (W)

Location as "NE/CNW/SW" or footage from lines NW NW SE  
Lease Owner Petroleum Management, Inc. for Anschutz Drilling Co.  
Lease Name Byer Well No. 1  
Office Address 1019 Central Building, Wichita, Kansas  
Character of Well (completed as Oil, Gas or Dry Hole) Dry  
Date well completed August 1, 1956  
Application for plugging filed October 8, 1956  
Application for plugging approved October 9, 1956  
Plugging commenced October 15, 1956  
Plugging completed October 30, 1956  
Reason for abandonment of well or producing formation Non Commercial

NORTH

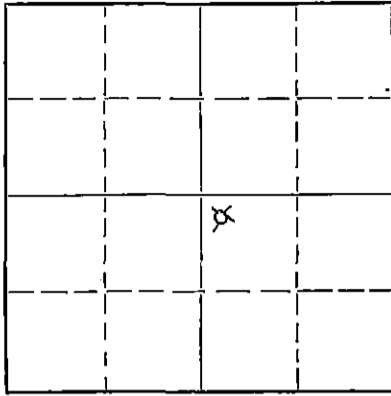

Locate well correctly on above  
Section Plat

If a producing well is abandoned, date of last production \_\_\_\_\_ 19\_\_\_\_  
Was permission obtained from the Conservation Division or its agents before plugging was commenced? Yes

Name of Conservation Agent who supervised plugging of this well R. M. Brundege  
Producing formation Viola Depth to top 3884 Bottom 3890 PB Total Depth of Well 4130 Feet  
Show depth and thickness of all water, oil and gas formations.

OIL, GAS OR WATER RECORDS

CASING RECORD

FORMATION	CONTENT	FROM	TO	SIZE	PUT IN	PULLED OUT
<u>Viola</u>	<u>Show of Oil</u>	<u>3884</u>	<u>3885</u>	<u>8 5/8"</u>	<u>246'</u>	<u>None</u>
	<u>Water</u>	<u>3885</u>	<u>3886</u>	<u>5 1/2</u>	<u>3928</u>	<u>2004</u>

Describe in detail the manner in which the well was plugged, indicating where the mud fluid was placed and the method or methods used in introducing it into the hole. If cement or other plugs were used, state the character of same and depth placed, from \_\_\_\_\_ feet to \_\_\_\_\_ feet for each plug set.

Plugged back with sand to 3875 ft.; dumped five sacks of cement. Pumped 20 sacks of mud and 10 sacks of cotton hulls down casing at 2877 ft. Mudded hole to 230 ft. Set rock bridge. Dumped 10 sacks of cement to top of surface pipe.

(If additional description is necessary, use BACK of this sheet)

Name of Plugging Contractor E & L Casing Pulling Co.  
Address Great Bend, Kansas

STATE OF Kansas, COUNTY OF Sedgwick, ss.

\_\_\_\_\_  
(employee of owner) or (owner or operator) of the above-described well, being first duly sworn on oath, says: That I have knowledge of the facts, statements, and matters herein contained and the log of the above-described well as filed and that the same are true and correct. So help me God.

(Signature) Gene Blum  
1019 Central Building, Wichita, Kansas  
(Address)

SUBSCRIBED AND SWORN TO before me this 21st day of November, 1956

My commission expires April 23, 1958

Mace C. Murphy  
Notary Public.

PLUGGING  
FILE SEC 17 T 24 R 12W  
BOOK PAGE 105 LINE 41

24-7388-5 3-53-20M RECEIVED  
STATE CORPORATION COMMISSION  
11-29-56  
11-25-1956  
CONSERVATION DIVISION  
Wichita, Kansas

PROCEEDINGS LOG

ANSLITZ DRILLING CO., INC.  
21 BY88  
N 1/4 SE Sec. 17-24-120  
Stafford County, Kansas

FEET	FEET	FORMATION
0	30	Surface clay
30	140	Sand
140	695	Red bed
695	735	Anhydrite
735	950	Shale
950	1350	Shale and shells
1660	2075	Lime
2075	2255	Lime and shale
2255	2385	Shale
2385	2505	Lime
2505	3310	Lime and shale
3310	3395	Lime
3395	3545	Lime and shale
3545	3900	Lime
3900	3930	Cherty lime
3930	4004	Lime and chert
3984	4012	Cherty lime
4012	4130	Lime
	4130	Rotary Total Depth

COMMENCED: 7/10/56

COMPLETED: 8/1/56

CASING RECORD:

Set 240' of 2-5/8" surface casing with 175 sacks cement, 2% gel, 200' calcium chloride.

Set 3923' of 5 1/2" oil string with 100 sacks cement.

STATE OF KANSAS  

I hereby affirm that the above and foregoing is a true and correct copy of the formations encountered on the 21 Over, N 1/4 SE of Section 17-24-120, Stafford County, Kansas, as reflected by the daily drilling reports.

ANSLITZ DRILLING CO., INC.

By: *Shirley Salley*  
Shirley Salley

Subscribed and sworn to before me this 11th day of August, 1956.

My Commission Expires: April 27, 1959.

*Kenneth P. Swenson*  
Kenneth P. Swenson, Notary Public

PLUGGING  
FILE SEC. 17, T. 24, R. 12W  
BOOK PAGE 105 LINE 41

STATE OF KANSAS  

RECEIVED

NOV 20 1956

CONSULTING ENGINEER  
Wichita, Kan.

PETROLEUM MANAGER